


Woodson

Form 51-5M-2-29-34703

Map No. KANSAS Sec. 35 Twp. 23 R. 13

Well No. 91-Brules Farm
Tarselson et al Company

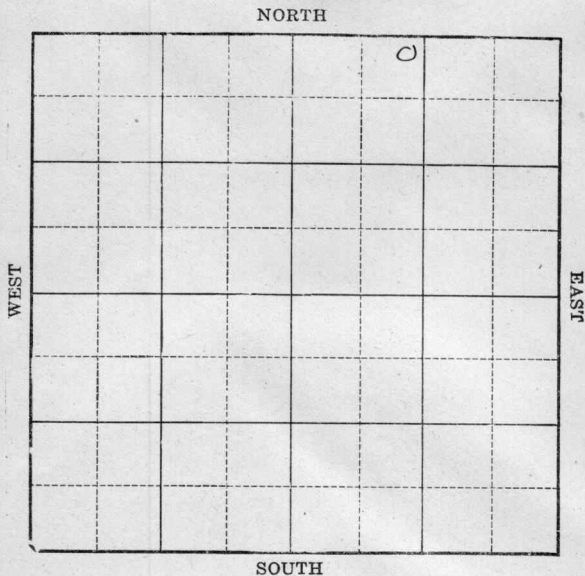

Location _____

Drilling Remarks _____

Rig Up _____

Drilling Remarks _____

RECORD

Cased _____ in. _____ ft.

Sand _____

Gas _____

Oil _____

Total Depth _____

PRODUCTION

1st 24 hrs. Nat. _____

1st 24 hrs. after shot _____

Gas _____ cu. ft.

Dry Hole _____

Abandoned _____

woodson

Map No. *16* Sec. *35* Twp. *23* R. *13*

Well No. *1* *Briles*

Sarselow et al Company

Contractor

FIRST REPORTS
ABANDONED

SECTION PLAT

..... Ft. from N. Line
..... Ft. from S. Line
..... Ft. from E. Line
..... Ft. from W. Line

		0	

Location.....

Rig up.....

Drilling and Remarks:

RECORD

Cased..... in., ft.
Sand.....
Gas.....
Oil.....
Total Depth *1961*

PRODUCTION

1st 24 hrs. Nat.....
1st 24 hrs. after shot.....
Gas..... Cu. Ft.
Dry Hole *✓*
Abandoned *✓*

Date *4/24/1923*

Sherwood Scout