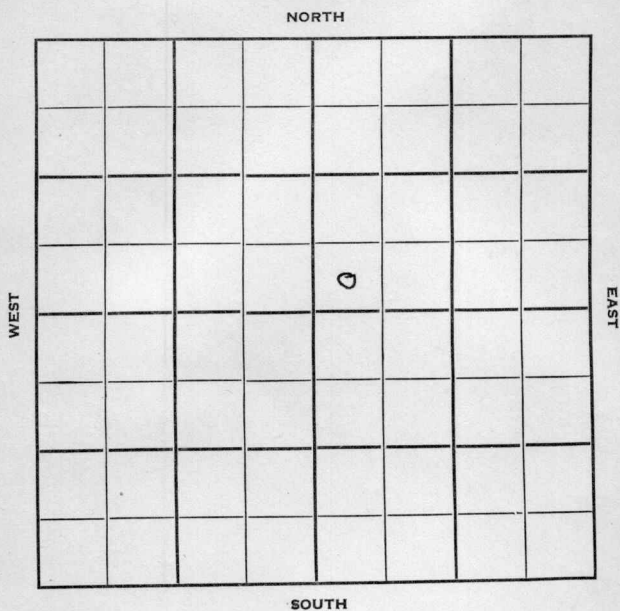


Section 35 Township 23 Range 13EWell No. #1 WellsCompany R. E. Smith

Woodson

KANSAS

Sec. 35 Twp. 23 R. 13E

Well No. #1 Wells Farm

R. E. Smith Company

Newland Contractor

 Ft. from N. Line

330


 Ft. from S. Line

 Ft. from E. Line

330

 Ft. from W. Line

SW SW NE

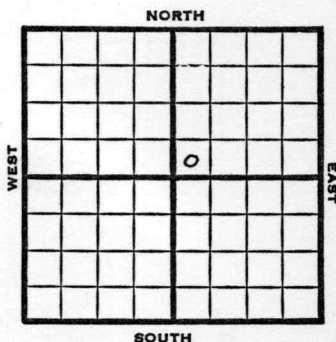

1952 Elev. - REPORT

10/82 10" @ 755'
Drlg. 990'

11/26 D&A
TD 1809
10" @ 755'
7" @ 1766
TD 1809'
D&A

ABANDONED

