


Well No. #3 Ames

Company Gulf

# NORTH Bloomer Pool

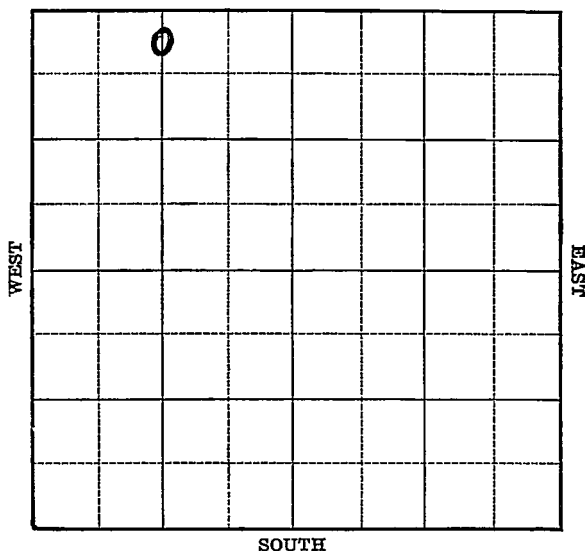



Map No. 55 Sec. 6 Twp. 18 R. 10WWell No. 3 AmesGulf

Company

Contractor

**FIRST REPORT**

C N L NW

330 Ft. from N. Line       Ft. from S. Line       Ft. from E. Line1320 Ft. from W. Line**BLOOMER POOL****SECTION PLAT**

|  |  |  |  |
|--|--|--|--|
|  |  |  |  |
|  |  |  |  |
|  |  |  |  |
|  |  |  |  |

Location                     Rig up                     Drilling and Remarks:                     **Rotary****RECORD**Cased            in.,            ft.Sand                     Gas                     Oil                     Total Depth                     **PRODUCTION**1st 24 hrs. Nat.                     1st 24 hrs. after shot                     Gas                      Cu. Ft.Dry Hole                     Abandoned                     

Date

AUG 16 1939 19S. J. LEWIS Scout

Rice

KANSAS

Map No. \_\_\_\_\_ Sec. 6 Twp. 18 R. 10WWell No. 3 Ames

Gulf

Company

Contractor

**COMPLETE**

C N L NW

330 Ft. from N. Line

\_\_\_\_\_ Ft. from S. Line

\_\_\_\_\_ Ft. from E. Line

1320 Ft. from W. Line

## SECTION PLAT

|  |  |  |  |
|--|--|--|--|
|  |  |  |  |
|  |  |  |  |
|  |  |  |  |
|  |  |  |  |

BLOOMER POOL

Location \_\_\_\_\_

Rig up \_\_\_\_\_

Drilling and Remarks:

*Ar 8325 1/2**50 @ 8259**Pump 163 oil  
cut 1 7/8 Water*

## RECORD

Cased \_\_\_\_\_ in., \_\_\_\_\_ ft.

Sand \_\_\_\_\_

Gas \_\_\_\_\_

Oil \_\_\_\_\_

Total Depth 9290

## PRODUCTION

1st 24 hrs. Nat. \_\_\_\_\_

1st 24 hrs. after shot \_\_\_\_\_

Gas \_\_\_\_\_ Cu. Ft.

Dry Hole \_\_\_\_\_

Abandoned \_\_\_\_\_

Date

SEP 13 1939 19 S I LEWIS Scout