

KANSAS


Rice

Form 51-5M-7-39-Palace

Section 6 Township 18 Range 10W

Well No. #3 Roesler

Company Transwestern et al

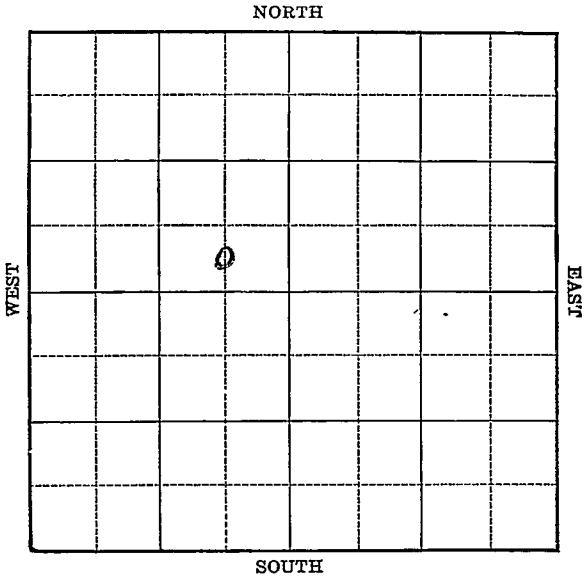

KANSAS . Rice

FORM 252-A 5M 2-40

Sec. 6 Twp. 18 R. 10-W

Well No. #3 Roesler Farm

Transwestern et al Company

(Bloomer)


_____ Ft. from N. Line

400
~~330~~ Ft. from S. Line

660 Ft. from E. Line

_____ Ft. from W. Line

Elev. 1794

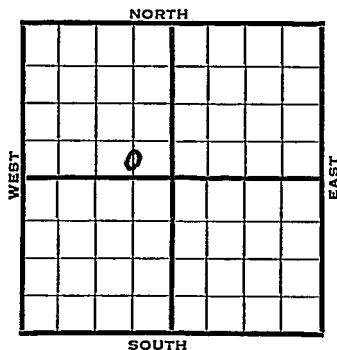

1940	REPORT
7/10	Derrick.
7/18	"
7/25	"
8/2	10" - 185'
	Drilg. 1951'
8/8	Lans. 2949' Arb. 3230-31' T.D.
	5" - 3231' RUST.
8/14	Arb. 3231 (Corrected)
	5" 3232-37 T.D. 300' oil
8/21	Arb. 3231'
	5" - 3232'
	T.D. 3237'
	Echometer potential 3917 bbls.
	Maximum 3000 bbls.
	COMPLETED

Map No. _____ Sec. 6 Twp. 18 R. 10W

Well No. 3 Roesler

Transwestern etal _____ Company

Contractor _____

FIRST REPORT

SECTION PLAT

C S L SE NW

_____ Ft. from N. Line

330 Ft. from S. Line

660 Ft. from E. Line

_____ Ft. from W. Line

BLOOMER POOL

Location _____

Rig up _____

Drilling and Remarks:

Derrick

RECORD

Cased _____ in., _____ ft.

Sand _____

Gas _____

Oil _____

Total Depth _____

PRODUCTION

1st 24 hrs. Nat. _____

1st 24 hrs. after shot _____

Gas _____ Cu. Ft.

Dry Hole _____

Abandoned _____

Date

JUL 10 19⁴⁰19

S. J. LEWIS Scout

Map No. _____ Sec. 6 Twp. 18 R. 10W

Well No. 3 Roesler

Transwestern Company

Contractor

C S L SE NW

SECTION PLAT

_____ Ft. from N. Line

400 Ft. from S. Line

660 Ft. from E. Line

_____ Ft. from W. Line

Bloomer Pool

Location _____

RECORD

Rig up _____

Cased _____ in., _____ ft.

Drilling and Remarks:

Sand _____

Reported as

Gas _____

330 x 660

Oil _____

Total Depth _____

PRODUCTION

1st 24 hrs. Nat. _____

1st 24 hrs. after shot _____

Gas _____ Cu. Ft.

Dry Hole _____

Abandoned _____

Date

JUL 1 - 1940

19

S. J. LEWIS Scout

Map No. _____ Sec. 6 Twp. 18 R. 10WWell No. 3 RoesslerTranswestern

Company

Contractor

COMPLETED**C S L SE NW**

_____ Ft. from N. Line

400 Ft. from S. Line660 Ft. from E. Line

_____ Ft. from W. Line

BLOOMER POOL**SECTION PLAT**

Location _____

Rig up _____

Drilling and Remarks:

*Per 3231**5" @ 3232**Eckometer P.O.**3917**Map 3000***RECORD**

Cased _____ in., _____ ft.

Sand _____

Gas _____

Oil _____

Total Depth 3237**PRODUCTION**

1st 24 hrs. Nat. _____

1st 24 hrs. after shot _____

Gas _____ Cu. Ft.

Dry Hole _____

Abandoned _____

Date

AUG 21 1940 19____S. J. LEWIS Scout