


Section 12 - Township 19 Range 12W

Well No. #1 Heinz "A"

Company Sohio Pet.

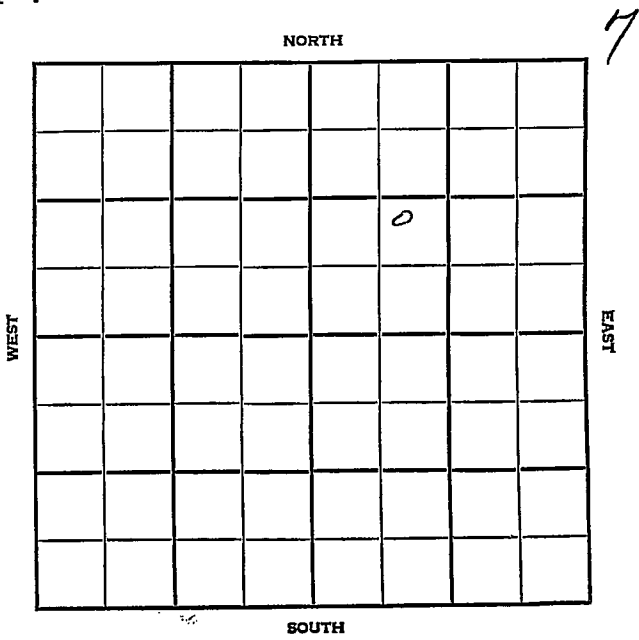

SEC.	TWP.	R.
12	19	12 W

WELL NO.

4 Heinz "A"

FARM

COMPANY

Sohio Pet.

CONTRACTOR

Garvey

Cheyenne View


_____ Ft. from N. Line

_____ Ft. from S. Line

_____ Ft. from E. Line

_____ Ft. from W. Line

NW SW NE

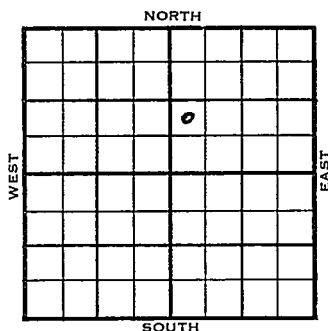

1955

ELEVATION

1809'

REPORT

6/22

Comm. 5-7-55

8" @ 650/320

DST 3091-3140, open 1 hr rec 55'

VSGCM 125/20"

DST 3210-57 open 1 hr, gas in 45

min, rec 60' HO & GCM, 240' G & MCO

485/20" 5½" @ 3356/150 GO to 3365

B/5 GO 3 GW 500 A B/1 BOPH 3 hr.

DD 3373 1000 A 3 BOPH DD 3382

2 BOPH 4 hr. PB 12/3242-46

12/3221-25 18/3112-18 12/3090-95

3000 A S/160 BO 24 hr.

P/93 BO 13 BW 24 hrs.

Comp. 93 BOPD 13 BW

TOPS:

Anh 634', Tp2692', H. 2952',

Tr. 2978', Dg. 2991', BL 3070',

L. 3090'

LOG: L. 3090', C. 3347', A. 3354'

TD 3365'

FIRST REPORT



COMPLETED

County Barton Elev. 1809
 Sec. 12 Twp. 15 Rgs. 12W
 Company Sohio Pet.
 Farm Name Heinz "A" No. 4

Co.

TOPS	DEPTH	LOG	DATUM
Anb.	634		
TP.	2692		883
H.	2952		1143
Tr.	2978		1169
Dg.	2991		1182
Bl.	3070		1261
L.	3090	3090	1281
K.C.			
B.K.C.			
Ce.			
C.		3347	1538
M.			
M.			
K.			
Mz.			
Me.			
V.			
S.			
S.			
A.		3354	1545
R.			
PE.	PF		1281-46
G.	52		
	PB		
T.D.	336.5		

Loc. in Sec. NW SW NE
 Geol. _____
 Contr. _____
 Pool _____
 Cheyenne View

Lse.

FIRST REPORT
 COMPLETE

No.

Date Comm. 5-7-55 JUN 22 1955
8" @ 650/320 DST 3091-3140 open 1 hr.
Rec. 55' vsgcm 125/20" DST 3210-57
open 1 hr. gas in 45 min. Rec. 60' ho
& gcm 240' g & mco 485/20" 5 1/2" @
3356/150 CO to 3365 B/.5 go 3 gw
500 A B/ 1 boph 3 hr. DD 3373
1000 A 3 boph DD 3382 2 boph 4 hr.
PB 12/ 3242-46 12/ 3221-25 18/ 3112
18 12 / 3090-95 / 3000 A

Sec.

T.

R.

OVER

S/ 160 bo 24 hr. P/ 93 bo 13 bw 24 hr.
Comp. 93 bopd 13 bw

_____	Misc.
_____	Place Map
_____	Ex. Sec. Map
_____	Tracings
_____	LAND WALL MAP
_____	LA. & S. WALL MAP
_____	Sec. 17 Cards

[Handwritten signature]

0000 92 1100