
FORM 51

Woodson KANSAS

Section 36 Township 23 Range 13E

Well No. 2 Wells

Company Bernard King

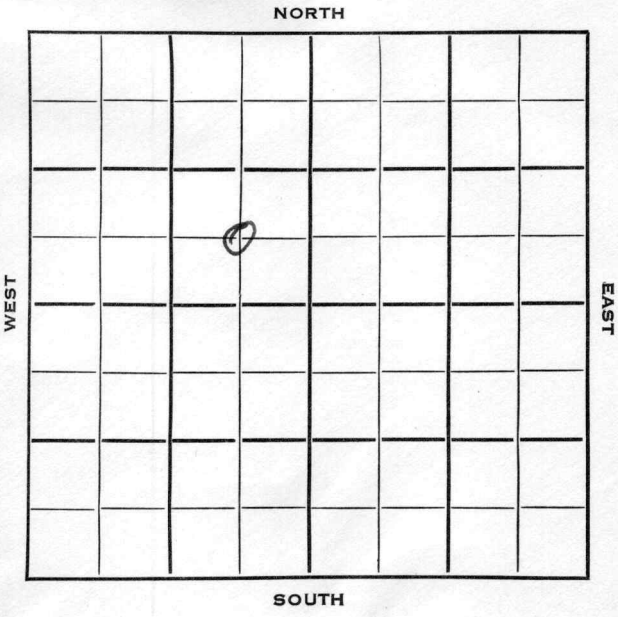

Coffey KANSAS

SEC.	TWP.	R.
36	23	13 E

WELL NO.

2 Wells FARM

COMPANY

Bernard King

CONTRACTOR

Sunflower Drlg. Co.


_____ Ft. from N. Line

660 Ft. from S. Line

660 Ft. from E. Line

_____ Ft. from W. Line

C SE NW

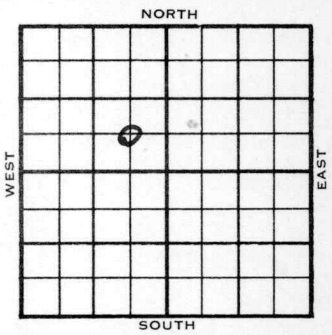

	ELEVATION	REPORT
1953	-	
10/14		Spud 9-23-53 10" @ 38 TD 1761' Holding for tops
10/21		Spud 9-23-53 10" @ 38' Miss 1721' TD 1761' D & A

ABANDONED

DX-78

FORM 275 FOR SALE BY KANSAS BLUE PRINT CO.

Woodson


County ~~Coffey~~ Greenwood State Kansas

Sec. 36 (Blk. Twp.) 23 (Sur. Rge.) 13E Map No.

Operator Bernard King

Well No. 2 Farm Wells

Elev. Location C SE NW

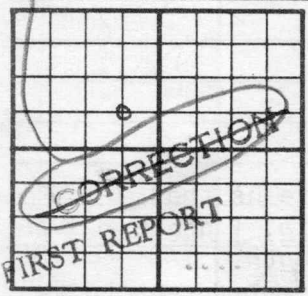

660 Ft. From S Line NW

660 Ft. From E Line Quarter

1st. Report OCT 14 1953

Completion

Remarks Sunflower Drlg. - Contr.

Spudding Date 9-23-53

Drlg. Data

10" @ 38 TD 1761 Holding for tops

J. G. McGEHEE

Hey Joe,

This is where Greenwood Co spills over into Coffee Co, so check the County I'll be much obliged.....!

Luville

Where is this Co. never heard of it. There is a Coffey Co. up here.

IN other words, you give us the wrong ¢¢/COUNTY or township, I don't know which. Please check both....
~~You stamped it correction~~ but forgot to.**

OCT 16 1953

Scout Cards mm
Land Small Map
Land Wall Map 63
Tracings
France Map
Pierce Map
Misc.

Drlg. Data

FORM 275 FOR SALE BY KANSAS BLUE PRINT CO.

Woodson

County ~~Coffey~~ State Kansas

Sec. 36 (Blk. Twp.) 23 (Sur. Rge.) 13E Map No.

Operator Bernard King

Well No. 2 Farm Wells

Elev. Location C SE NW



660 Ft. From S Line NW

660 Ft. From E Line Quarter

1st. Report

Completion OCT 21 1953

Remarks

Sunflower Drlg. - Contr.

Spudding Date 9-23-53

Drlg. Data

10" @ 38 Miss. 1721 TD 1761

D & A

J. G. McGEHEE