

Section 36 Township 23 Range 13-E

Well No. 1 Wells

Company L. Wondra

Virgil Pool

NORTH

WEST

EAST

|   |  |  |  |  |  |  |  |
|---|--|--|--|--|--|--|--|
|   |  |  |  |  |  |  |  |
| 0 |  |  |  |  |  |  |  |
|   |  |  |  |  |  |  |  |
|   |  |  |  |  |  |  |  |
SOUTH

Sec. 36 Twp. 23 R. 13-E

Well No. #1 Wells Farm

L. Wondra Company

Virgil Pool

990


Ft. from N. Line

Ft. from S. Line

Ft. from E. Line

330

Ft. from W. Line

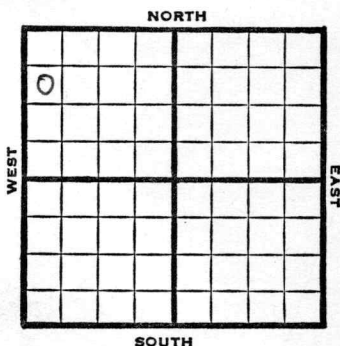

SW NW NW

# REPORT

1947

7/2 Drlg 1460'

7/8 "

7/16 Mississippi 1776-82' TD  
7" @ 1776' - 2000 acid.

7/23 Miss. 1766'  
7" @ 1768'  
Pump 65 Pot.  
Gr. 38  
T. . . 1773'  
Complete

COMPLETED

Map No. \_\_\_\_\_ Sec. 36 Twp. 23 R. 13E

Well No. 1 Wells

L. Wondra Company

**FIRST REPORT**

Contractor

SW NW NW


**SECTION PLAT**

990 Ft. from N. Line

\_\_\_\_\_ Ft. from S. Line

\_\_\_\_\_ Ft. from E. Line

330 Ft. from W. Line

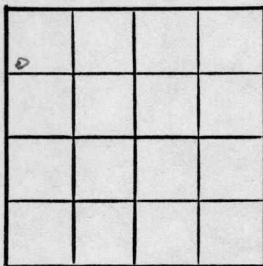

Woodson County

Location \_\_\_\_\_

Rig up \_\_\_\_\_

Drilling and Remarks:

drlg. 1460

**RECORD**

Cased \_\_\_\_\_ in., \_\_\_\_\_ ft.

Sand \_\_\_\_\_

Gas \_\_\_\_\_

Oil \_\_\_\_\_

Total Depth \_\_\_\_\_

**PRODUCTION**

1st 24 hrs. Nat. \_\_\_\_\_

1st 24 hrs. after shot \_\_\_\_\_

Gas \_\_\_\_\_ Cu. Ft.

Dry Hole \_\_\_\_\_

Abandoned \_\_\_\_\_

Date

JUL 2 1947 19

S. J. LEWIS

Scout

Map No. 17 Sec. 36 Twp. 23 R. 13E

Well No. 1 Wells

L. Wondra Company

COMPLETE Contractor

SW NW NW

SECTION PLAT

990 Ft. from N. Line

         Ft. from S. Line

         Ft. from E. Line

330 Ft. from W. Line

|   |  |  |  |
|---|--|--|--|
|   |  |  |  |
| 0 |  |  |  |
|   |  |  |  |
|   |  |  |  |
|   |  |  |  |

Woodson County

Location                     

Rig up                     

Drilling and Remarks:

*Miss 1766*

*7" @ 1768*

*Pump 65 Bx*

*28" - 1/2"*

RECORD

Cased          in.,          ft.

Sand                     

Gas                     

Oil                     

Total Depth 1728

PRODUCTION

1st 24 hrs. Nat.                     

1st 24 hrs. after shot                     

Gas                      Cu. Ft.

Dry Hole                     

Abandoned                     

Date

JUL 23 1947 19

S. J. LEWIS Scout