
DX 78-1 Woodson KANSAS

Section 36 Township 23 Range 13E

Well No. #1 C. E. Wells

Company John Haas

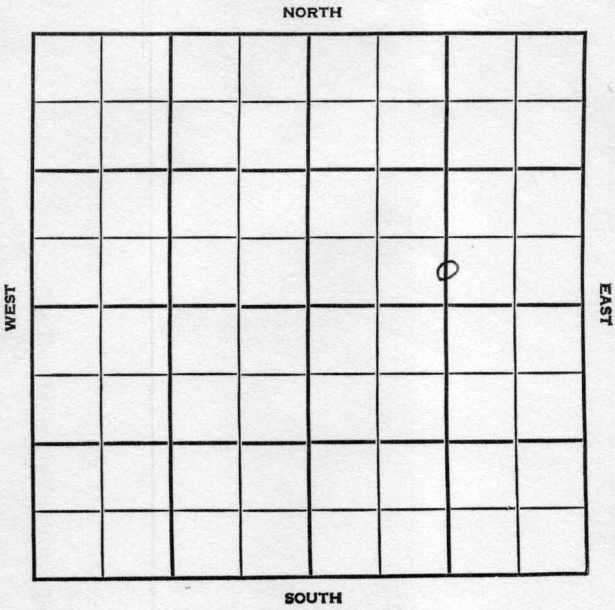

SEC.	TWP.	R.
36	23	13E

Woodson KANSAS

WELL NO.

#1 C. E. Wells FARM

COMPANY

John Haas

CONTRACTOR

Co. tools


M. Virgil

_____ FT. FROM N. LINE

_____ FT. FROM S. LINE

_____ FT. FROM E. LINE

_____ FT. FROM W. LINE

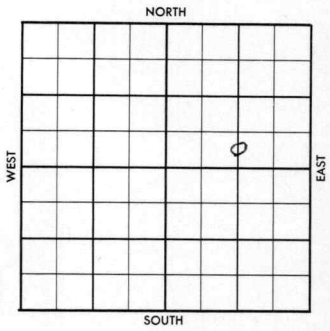

C S½ S½ NE
Miss. L. test

1956	ELEVATION REPORT
6-27	M I M
8-1	10 3/4" @ 40 w/5 Hole full water D & A Sgr. 1275'; Bartl. 1585';M.Li. 1720'; TD 1740

ABANDONED

FORM 504-5 SUNRAY

FORM 513 SUNRAY

County Woodson Elev.

Sec. 36 Twp. 23 Rge. 13E

Company John Haas

Farm Name C. E. Wells No. 1

TOPS	DEPTH	LOG	DATUM
Anh.			
Tp.			
H.			
Tr.			
Dg.			
B.L.			
L.			
K.C.			
B.K.C.			
Ce.			
C.			
M.			
M.			
K.			
Mz.			
Mo.			
V.			
S.			
S.			
A			
R.			
P€.			
G.			
T.D.			

Loc. in Sec. C S½ S½ NE

Miss. L test

Geol.

Contr. Co. tools

Pool N. Virgil



Date Comm. M I M

Co. Lse. No. Sec. T. R.

FORM 513 SUNRAY

County Woodson Elev.

Sec. 36 Twp. 23 Rge. 13E

Company John Haas

Farm Name C. E. Wells No. 1

TOPS	DEPTH	LOG	DATUM
Anh.			
Tp.			
H.			
Tr.			
~~Dg.~~ SGC.	1225		
Bl.			
L.			
K.C. Darh.	1585		
B.K.C.			
Ce.			
C.			
M. LI	1720		
M.			
K.			
Mz.			
Mo.			
V.			
S.			
S.			
A			
R.			
P€.			
G.			
T.D.	1740		

Loc. in Sec. C S½ S½ NE

Miss. L test

Geol.

Contr. Co. tools

Lse.

Pool N. Virgil

ABANDONED

AUG 1 1956

Date Comm.

M I M JUL 3 '56 RUCT JUL 11 '56 10 3/4

40/5 Ø 300 JUL 18 '56 Ø 846

JUL 25 '56 Ø 1350 AUG 1 '56

Hole Full wtr

OAQ

Co. No. Sec. T. R.