


Section 8 Township 27 Range 6 E

Well No. # 2 Grace Deitrick

Company Aikman & Braden

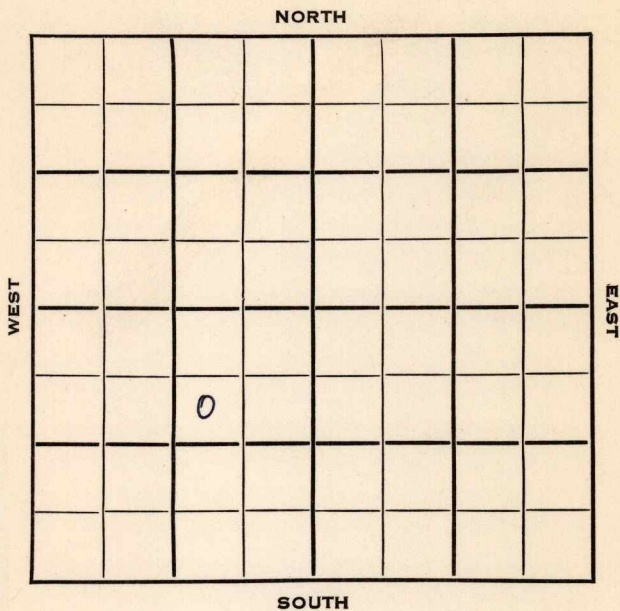

Butler KANSAS

SEC. 8 TWP. 27 R. 6E ✓

WELL NO. 2 Grace Dietrick FARM

COMPANY Aikman & Braden

CONTRACTOR Reynolds-Shaffer Pool


~~990x~~

990 Ft. from N. Line

Ft. from S. Line

990 Ft. from E. Line

Ft. from W. Line

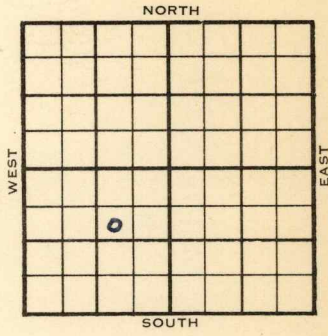

SW NE SW

1953 ELEVATION 1395' REPORT

12/2 Spud 11-19-53
 13" @ 75'
 Drlg. 1365'

12/22 Spud 11-19-53
 Oil Well
 TD 2794'
 13" @ 759'
 15" @ 75'
 KC 2136', Miss 2738'
 7" @ 2758'
 TD 2794'
 S/ 15 bopd 50% wtr.
 Comp 25 bopd 25 bw.

COMPLETED

County Butler State Kansas

Sec. 8 (Blk. 27 (Sur. 6E (Twp.) (Rge.) Map No.

Operator Aikman & Braden

Well No. 2 Farm Grace Dietrick

Elev. Location SW NE SW

FIRST REPORT					

990 Ft. From N Line SW

990 Ft. From E Line Quarter

1st. Report DEC 2 1953

Completion

Remarks

Aikman & Braden - Contr.

Spudding Date 11-19-53

Drlg. Data Reynolds-Shaffer Pool

13" @ 75 drlg. 1365

County Butler State Kansas

Sec. 8 (Blk. 27 (Sur. 6E Map No.

Operator Aikman & Braden

Well No. 2 Farm Grace Dietrick

Elev. 1395 Location SW NE SW

COMPLETE							

990 Ft. From N Line SW

990 Ft. From E Line Quarter

1st. Report

Completion DEC 22 1953

Remarks Reynolds-Shaffer Pool

Aikman & Braden - Contr.

Spudding Date 11-19-53

Drlg. Data Oil well TD 2794

13" @ 759 15" @ 75 KC 2136

Miss. 2738 7" @ 2758 TD 2794

S/ 15 bopd 50% wtr.

Comp. 25 bopd 25 bw