


Map No. Kansas Sec. 8 Twp. 27 R. 6

Well No. 1 Brussey Farm  
Richmond Dy Company

NORTH

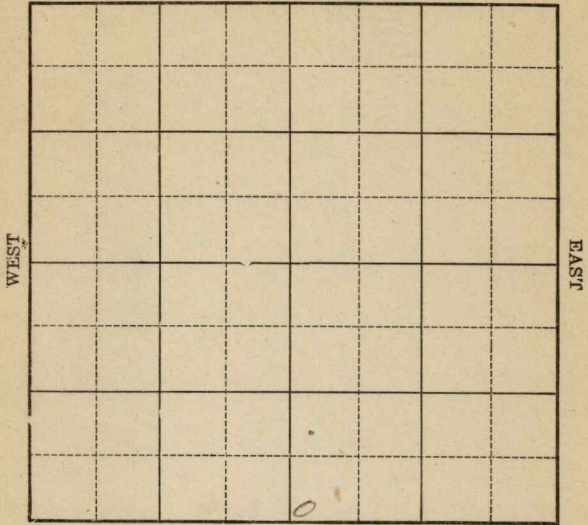

SOUTH

Location \_\_\_\_\_

Rig Up \_\_\_\_\_

Drilling Remarks \_\_\_\_\_

Drilling Remarks \_\_\_\_\_

\_\_\_\_\_

\_\_\_\_\_

**RECORD**

**PRODUCTION**

Cased \_\_\_\_\_ in. \_\_\_\_\_ ft.

1st 24 hrs. Nat. \_\_\_\_\_

Sand \_\_\_\_\_

1st 24 hrs. after shot \_\_\_\_\_

Gas \_\_\_\_\_

Gas \_\_\_\_\_ cu. ft.

Oil \_\_\_\_\_

Dry Hole \_\_\_\_\_

Total Depth \_\_\_\_\_

Abandoned \_\_\_\_\_

Butler Co

Map No. Kansas Sec. 8 Twp. 27 R. 6

Well No. 1 Brussey Farm  
Richmond Olg Company


NORTH

..... Ft. from N. Line

250 Ft. from S. Line

..... Ft. from E. Line

250 Ft. from W. Line

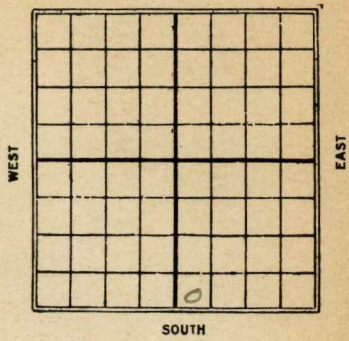

Date	REPORT
<u>12/5</u>	
<u>12/3</u>	<u>Bldg Rig</u>
<u>12/3</u>	
<u>12/10</u>	<u>log</u>
<u>12/17</u>	<u>Spudding</u>
<u>12/23</u>	
<u>12/31</u>	<u>Drlg 1140'</u>
<u>1926</u>	
<u>1/8</u>	<u>Drlg 1450'</u>
<u>1/14</u>	<u>✓ 2150</u>
<u>20</u>	<u>U.R. 2400'</u>
<u>27</u>	<u>Drlg 2458'</u>
<u>2/4</u>	<u>✓ 2680'</u>
<u>2/10</u>	<u>I.S. 2875-2877' show oil</u>
	<u>S. D for orders</u>
<u>2/17</u>	—
<u>2/24</u>	<u>Dlg 2975'</u>
<u>3/5</u>	<u>Top line 2840'</u>
	<u>Show oil 3125' and 5"</u>
<u>3/10</u>	<u>Top. Wilcox sand 3122-</u>
	<u>26 filled up 2200' 24</u>
	<u>hours swabbed 406 bbls</u>
	<u>first 18 hours.</u>

3/18- Sand 3122-26 Pumping  
35 bbls. Some water

Bother Co

Map No. KANSAS Sec. 8 Twp. 27 R. 6

Well No. 1 Blissey

Richmond Drilling Co Company

Contractor

SECTION PLAT


----- Ft. from N. Line

250

----- Ft. from S. Line

----- Ft. from E. Line

250

----- Ft. from W. Line

FIRST REPORTS

Location -----

Rig up -----

Drilling and Remarks:

Blg Rig

RECORD

Cased ----- in., ----- ft.

Sand -----

Gas -----

Oil -----

Total Depth -----

PRODUCTION

1st 24 hrs. Nat. -----

1st 24 hrs. after shot -----

Gas ----- Cu. Ft.

Dry Hole -----

Abandoned -----

Date

DEC 3 1925

CHAS. L. SHERWOOD

192

Scout

Map No. **K11 KANSAS** Sec. **8** Twp. **27** R. **6**

Well No. **1**

**Richmond Oil Co** Company

Contractor

**COMPLETED**

**SECTION PLAT**

\_\_\_\_\_ Ft. from N. Line

**250** Ft. from S. Line

\_\_\_\_\_ Ft. from E. Line

**250** Ft. from W. Line

		0	

Location \_\_\_\_\_

Rig up \_\_\_\_\_

Drilling and Remarks:

*top line 2840'*  
*show oil 2875-77*  
*top Wilcox 3,22-*  
*3,26'*  
*pumping 35 lbs.*  
*some water.*

**RECORD**

Cased \_\_\_\_\_ in., \_\_\_\_\_ ft.  
 Sand **3,22-3,26'**  
 Gas \_\_\_\_\_  
 Oil \_\_\_\_\_  
 Total Depth **3,26'**

**PRODUCTION**

1st 24 hrs. Nat. \_\_\_\_\_  
 1st 24 hrs. after shot \_\_\_\_\_  
 Gas \_\_\_\_\_ Cu. Ft.  
 Dry Hole \_\_\_\_\_  
 Abandoned \_\_\_\_\_

Date

**MAR 18 1926**

**CHAS. L. SHERWOOD**

192

Scout