


Section 1 Township 23 Range 14-E

Well Number #5-Rossillion

Company Franklin Dlg.

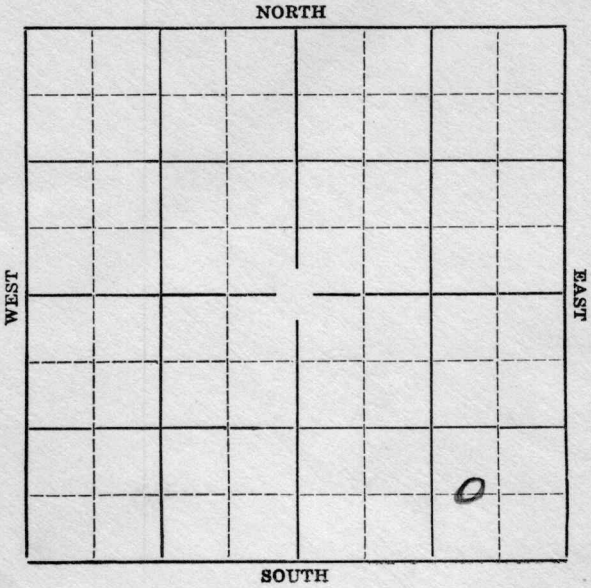

Sec. 1 Twp. 23 R. 14E


Well No. #5 Rossillion Farm
Franklin Drlg. Company

 Ft. from N. Line

660' Ft. from S. Line

330' Ft. from E. Line

~~990'~~ Ft. from W. Line

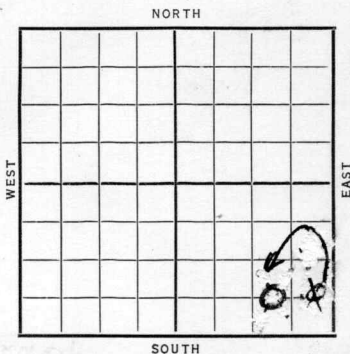

Tricket Returned

~~1936~~ 1936

REPORT

9/9 Machine.

9/18 Rigging up.

9/24 Drilling 700'.

10/1 Drlg. 1165'.

10/8 Peru sand 1147'. S.O. and gas
 1243'. T.D. 1447'. Shut down.

10/15 Mississippi L. 1506'. Set 6"
 T.D. 1517'. Waiting on cement.

~~10/20/36~~

*10/20/36 - Mississippi Lime 1506'
 Pay 1544-48'
 1500 gallons of acid
 Potential 68 bbls of oil.*

COMPLETED

Tricket Returned

Map No. 117 Sec. 1 Twp. 23 R. 14E

Well No. 5 Rossillon

Franklin D. G. Company

Contractor

SECTION PLAT

 Ft. from N. Line

660 Ft. from S. Line

 Ft. from E. Line

990 Ft. from W. Line

FIRST REPORT

Location

Rig up

Drilling and Remarks:

Wack.

RECORD

Cased in., ft.

Sand

Gas

Oil

Total Depth

PRODUCTION

1st 24 hrs. Nat.

1st 24 hrs. after shot

Gas Cu. Ft.

Dry Hole

Abandoned

Date

SEP 9 1936 19

S. J. LEWIS

Scout

Map No. 17 Sec. 1 Twp. 23 R. 14E

Well No. 5 Rossilan

Franklin Dillig Company

Contractor

SECTION PLAT

_____ Ft. from N. Line

660 Ft. from S. Line

_____ Ft. from E. Line

330 Ft. from W. Line

			0

COMPLETED

Location _____

Rig up _____

Drilling and Remarks:

*Miss L 1506
Pay 1544-48
Boo acid
P 868 1/2*

RECORD

Cased _____ in., _____ ft.

Sand _____

Gas _____

Oil _____

Total Depth 1549

PRODUCTION

1st 24 hrs. Nat. _____

1st 24 hrs. after shot _____

Gas _____ Cu. Ft.

Dry Hole _____

Abandoned _____

Date

11/5/36. 19

S. J. LEWIS

Scout