Coffey


Form 51—5M—2-29—34703

KANSAS

Map No. ____ Sec. 3 Twp. 23 R. 14

Well No. 1 Ludwick Prokop Farm

? ? Company

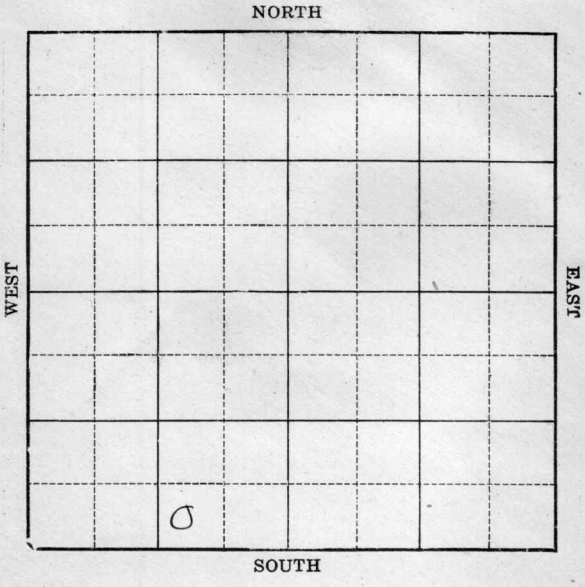

Location	Rig Up
Drilling Remarks	Drilling Remarks

RECORD			PRODUCTION	
Cased	in.	ft.	1st 24 hrs. Nat.	
Sand			1st 24 hrs. after shot	
Gas			Gas	cu. ft.
Oil			Dry Hole	
Total Depth			Abandoned	

Form 26—1M Bks.—9-26

Copper

Map No. ..... Sec. 3 Twp. 23 R. 14


Well No. 1 Ludwick Prokop

? .....Company

.....Contractor

FIRST REPORTS ABANDONED

SECTION PLAT

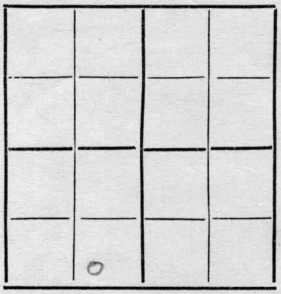

.....Ft. from N. Line

.....Ft. from S. Line

.....Ft. from E. Line

.....Ft. from W. Line

Location.....

Rig up.....

Drilling and Remarks:

Broken Lime
1591-1620'
HFW 1672-66'

RECORD

Cased.....in., ...ft.

Sand.....

Gas.....

Oil.....

Total Depth 1666

PRODUCTION

1st 24 hrs. Nat.....

1st 24 hrs. after shot.....

Gas.....Cu. Ft.

Dry Hole ✓

Abandoned ✓

Date

1/2/21 192.....

Sherwood .....Scout