SIDE ONE

CONFIDENTIAL MAR 8 1985

STATE CORPORATION COMMISSION OF KANSAS
OIL & GAS CONSERVATION DIVISION

WELL COMPLETION OR RECOMPLETION FORM
ACO–1 WELL HISTORY

DESCRIPTION OF WELL AND LEASE

Operator: license # 5118
name T.G.T. Petroleum Corp.
address 209 E. William
City/State/Zip Wichita, Ks. 67202

Operator Contact Person B. Lynn Herrington
Phone 262-6489

Contractor: license # 5422
name Abercrombie Drilling, Inc.

Wellsite Geologist Al Stude
Phone 262-0902
PURCHASER

Designate Type of Completion
☒ New Well ☐ Re-Entry ☐ Workover

☐ Oil ☐ SWD ☐ Temp Abd
☐ Gas ☐ Inj ☐ Delayed Comp.
☒ Dry ☐ Other (Core, Water Supply etc.)

RECEIVED
STATE CORPORATION COMMISSION
MAR 07 1985
CONSERVATION DIVISION
Wichita, Kansas

If WO: old well info as follows:
Operator
Well Name
Comp. Date Old Total Depth

API NO. 15 - 047-21,216

State Geological Survey
WICHITA BRANCH

County Edwards

NW SE Sec 9 Twp 26S Rge 19 X
(location)

1980 Ft North from Southeast Corner of Sec
1980 Ft West from Southeast Corner of Sec
(Note: locate well in section plat below)


Lease Name Kuhn "A" Well# 1

Field Name

Producing Formation

Elevation: Ground 2222 KB 2234

Section Plat

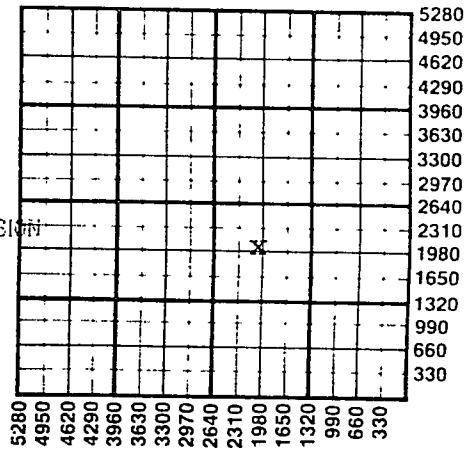

WELL HISTORY

Drilling Method: ☒ Mud Rotary ☐ Air Rotary ☐ Cable

12-4-84	12-20-84	12-20-84
Spud Date	Date Reached TD	Completion Date
4973'		
Total Depth	PBTD	

Amount of Surface Pipe Set and Cemented at 420.87' @ 438' feet

Multiple Stage Cementing Collar Used? ☐ Yes ☐ No

If Yes, Show Depth Set feet

If alternate 2 completion, cement circulated
from feet depth to w/ SX cmt

WATER SUPPLY INFORMATION

Source of Water:

Division of Water Resources Permit #

☒ Groundwater 2010 Ft North From Southeast Corner
(Well) 2070 Ft. West From Southeast Corner
Sec 9 Twp 26S Rge 19 ☐ East ☒ West

☐ Surface Water Ft North From Southeast Corner
(Stream, Pond etc.) Ft West From Southeast Corner
Sec Twp Rge ☐ East ☐ West

☐ Other (explain)
(purchased from city, R.W.D.#)

Disposition of Produced Water: ☐ Disposal ☐ Repressuring

Docket #

INSTRUCTIONS: This form shall be completed in duplicate and filed with the Kansas Corporation Commission, 200 Colorado Derby Buildin Wichita, Kansas 67202, within 90 days after completion or recompletion of any well. Rules 82-3-130 and 82-3-107 apply.

Information on side two of this form will be held confidential for a period of 12 months if requested in writing and submitted with the form. See rule 82-3-1(for confidentiality in excess of 12 months.

One copy of all wireline logs and drillers time log shall be attached with this form. Submit CP-4 form with all plugged wells. Submit CP-111 form wi all temporarily abandoned wells.