


KANSAS

Section 22 Township 23 S Range 13 E

Well No. #14 Shambaugh "A"

Company MID-CONTINENT PET.

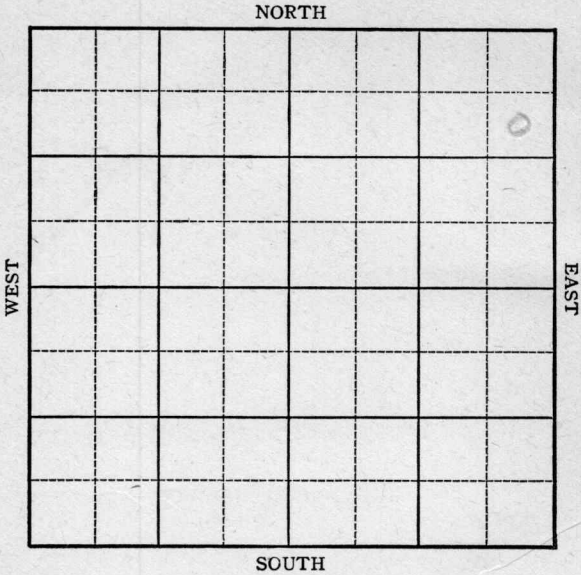

KANSAS Greenwood County

Sec. 22 Twp. 23 R. 13E

Well No. #14 Shambaugh "A" Farm
Mid-Continent Pet. Company

Virgil


990 Ft. from N. Line

_____ Ft. from S. Line

330 Ft. from E. Line

_____ Ft. from W. Line

SE NE NE

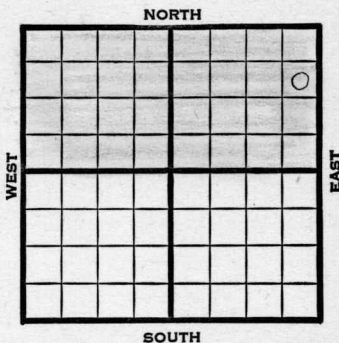

1945

REPORT

- 4/11 Loc. 4-9-45
8-1/4" @ 31' WOC
- 5-5 Acidized w/2000 gal.
Will test.
- 5-7 Pumped 5 bbls. above load.
Will test 2 more days.
- 5-9 Testing.
- 5-11 Total Depth 1792'
~~Testing. cement.~~
- 5-16 Total Depth 1792'
Completed 5-15-45
10 bbls. per day on pump
- 5/16 Miss 1750
5" @ 1761
TD 1792
2000 acid.
Pump 10 Pot.
Grav. 38.0

COMPLETED

Pool Name Virgil

Map No. 17 Kansas Sec. 22 Twp. 23 R. 13E

Well No. 14 Shambaugh "A"

Mid-Continent Pet. Company

FIRST REPORT Contractor

SE NE NE

SECTION PLAT

990 Ft. from N. Line

 Ft. from S. Line

330 Ft. from E. Line

 Ft. from W. Line

			o

Greenwood

Location 4-9-45

Rig up

Drilling and Remarks:

8 1/2" -31 WOC

RECORD

Cased in., ft.

Sand

Gas

Oil

Total Depth

PRODUCTION

1st 24 hrs. Nat.

1st 24 hrs. after shot

Gas Cu. Ft.

Dry Hole

Abandoned

Date

APR 11 1945 19

S. J. LEWIS Scout

Kansas Pool Name Virgil

Map No. 17 Sec. 22 Twp. 23 R. 13E

Well No. 14 Shambaugh "A"

Mid-Continent Pet. Company

COMPLETED

Contractor

SE NE NE

SECTION PLAT

990 Ft. from N. Line

_____ Ft. from S. Line

330 Ft. from E. Line

_____ Ft. from W. Line

			o

Greenwood County

Location _____

Rig up _____

Drilling and Remarks:

Misc 1750
5" @ 1761
2000 acid
Pump 10 BT
38° G

RECORD

Cased _____ in., _____ ft.

Sand _____

Gas _____

Oil _____

Total Depth 1792

PRODUCTION

1st 24 hrs. Nat. _____

1st 24 hrs. after shot _____

Gas _____ Cu. Ft.

Dry Hole _____

Abandoned _____

Date

MAY 16 1945 19

S. J. LEWIS Scout