


KANSAS

FORM 51 5M BRIX

Section 22 Township 23 Range 13E

Well No. 13 Shambaugh "A"

Company Mid-Continent Pet.

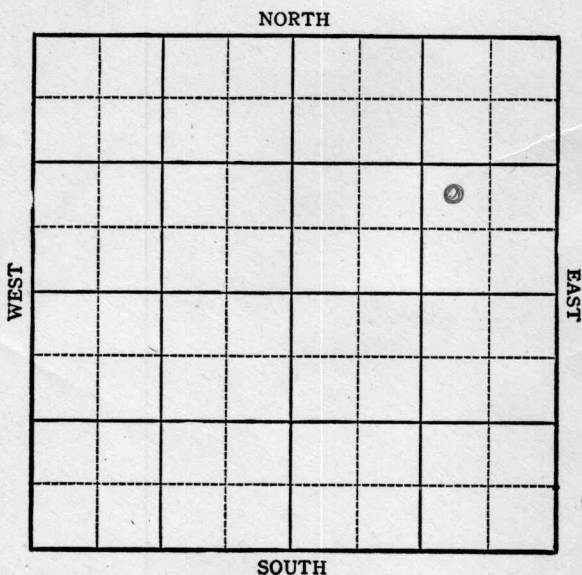

KANSAS Greenwood

Sec. 22 Twp. 23 R. 13E

Well No. #13 Shambaugh "A" Farm
Mic-Continent Pet Company


Virgil

_____ Ft. from N. Line

990 _____ Ft. from S. Line

990 _____ Ft. from E. Line

_____ Ft. from W. Line

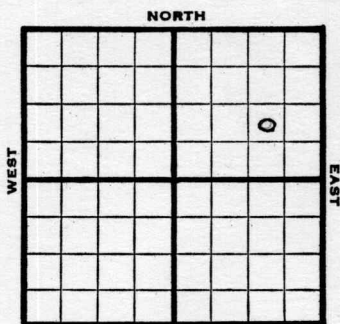

1944

REPORT

8/30

Surface hole.

9/8

8" @ 24' Drlg. 660

9/13

Chat 1710-k3TD 5" @ 1712' RUST

9/21

TD 1749 SO

9/27

Chat 1710

5" @ 1712

1000 acid

Pump 10 oil plus 30 wtr Pot.

Grav. 36.

TD 1749

COMPLETED

