


Map No. Kansas Sec. 22 Twp. 23 R. 13
 Well No. 13 C. M. Shambaugh Farm
Mid-Conit Pet Corp Company

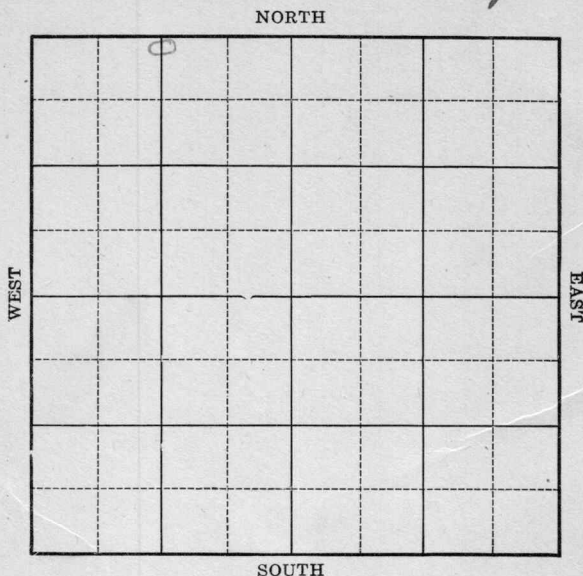

Location _____

Drilling Remarks

RECORD

Cased _____ in. _____ ft.
 Sand _____
 Gas _____
 Oil _____
 Total Depth _____

Rig Up _____

Drilling Remarks

PRODUCTION

1st 24 hrs. Nat. _____
 1st 24 hrs. after shot _____
 Gas _____ cu. ft.
 Dry Hole _____
 Abandoned _____

Map No. **KANSAS** Sec. **22** Twp. **23** R. **12**
 Well No. **12** **Shambaugh** Farm
Mid-Continent Pet Company


200 Ft. from N. Line

_____ Ft. from S. Line

_____ Ft. from E. Line

1320 Ft. from W. Line

1926

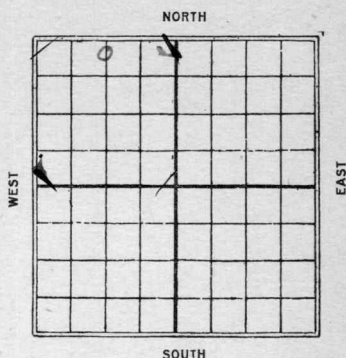

Date

REPORT


2/10	Reg
2/24	Spudg 100'
3/5	12 1/2 at 412. Slg 640'
3/10	Slg 1340
3/18	J. Broken Sd. 1585'
	Sho oil J.D. 1625' S.D. shoot ^{may}
3/25	
4/1	Shot 80 ats, pumping 80 Bbl
4/7	Sand 1585-1625
	80 gte 80 bbls

Sherwood Co

K17
Map No. **KANSAS** Sec. **22** Twp. **23** R. **13**Well No. **12 C.M. Shambaugh**
Mid. Cont Let Corp Company

Contractor

SECTION PLAT

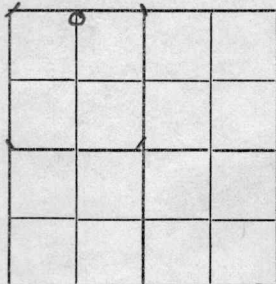**200** Ft. from N. Line

Ft. from S. Line

Ft. from E. Line

1320 Ft. from W. Line

FIRST REPORTS

Location ☒Rig up ☒

Drilling and Remarks:

RECORD

Cased _____ in., _____ ft.

Sand _____

Gas _____

Oil _____

Total Depth _____

PRODUCTION

1st 24 hrs. Nat. _____

1st 24 hrs. after shot _____

Gas _____ Cu. Ft.

Dry Hole _____

Abandoned _____

Date

FEB 10 1926

192

CHAS. L. SHERWOOD

Scout

Sherwood
 K17 KANSAS Map No. *22* Sec. *23* Twp. *13* R. *13*
 Well No. *12* *C. M. Shambaugh*
M. S. Cont. Ref. Corp. Company

Contractor

COMPLETED

SECTION PLAT

200 Ft. from N. Line

Ft. from S. Line

Ft. from E. Line

1320 Ft. from W. Line

Location

Rig up

Drilling and Remarks:

80y 80 lbs.

RECORD

Cased *1585-1625* in. ft.

Sand

Gas

Oil

Total Depth *1625'*

PRODUCTION

1st 24 hrs. Nat.

1st 24 hrs. after shot

Gas Cu. Ft.

Dry Hole

Abandoned

Date

APR 7 1926

192

CHAS. L. SHERWOOD

Scout