


Section 22 Township 23 Range 13E

Well No. #11 C.N. Shambaugh "A"

Company Mid-Continent Petroleum Corp.

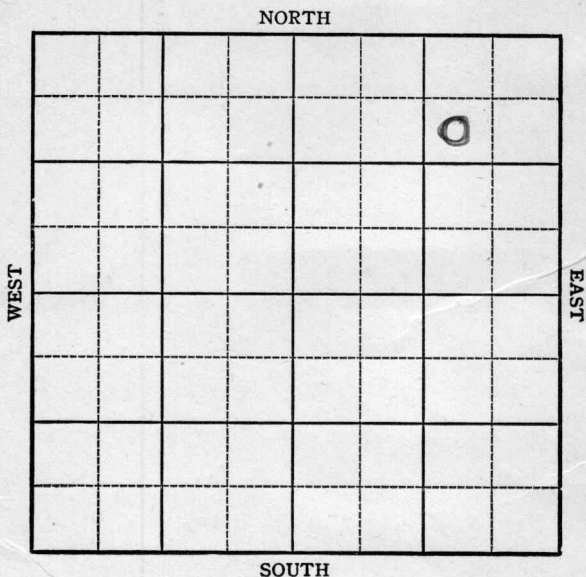

Sec. 22 Twp. 23-S R. 13-E

Well No. #11 C. N. Shanbaugh "A" Farm

Mid-Continent Petr. Corp. Company

NORTH

990 Ft. from N. Line

Ft. from S. Line

990 Ft. from E. Line

Ft. from W. Line

WEST

EAST

SOUTH

NE/4

REPORT

1944

3/30

Location Notice

4/5

Rotary

4/19

"

5/1

Top Chat 1733; good odor
Set 7" casing 1734' with 150 Sacks
W.O.C. to set.

5/3

Bart 1636
Miss chat 1733-46
TD 6 5/8" 1744 RUST

5/6

Waiting on machine T.D. 1744'

5/12

Set 7" casing 1744'
Bailing mud today

5/16

Re-cementing 7" casing

5/24

Re-cementing 6-5/8" TD 1746

5/31

TD 1775
Pump 3 1/2 oil in 16 hrs.
500 acid.

6/7

Pump 15 oil in 19 hrs.
1000 acid.

6/14

Miss. 1733
6-5/8" @ 1744 1500 acid
TD 1775
Pump 15 Pot.
Grav. 38.0

COMPLETED

Pool Name Virgil

Map No. KANSAS 7 Sec. 22 Twp. 23 R. 13E

Well No. 11 C. N. Shambaugh "A"

Mid-Continent Petroleum Corp. Company

FIRST REPORT

Contractor _____

SW NE NE


SECTION PLAT

990 Ft. from N. Line

_____ Ft. from S. Line

990 Ft. from E. Line

_____ Ft. from W. Line

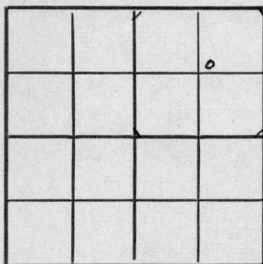

Greenwood County

Location _____

Rig up _____

Drilling and Remarks:

Rotary

RECORD

Cased _____ in., _____ ft.

Sand _____

Gas _____

Oil _____

Total Depth _____

PRODUCTION

1st 24 hrs. Nat. _____

1st 24 hrs. after shot _____

Gas _____ Cu. Ft.

Dry Hole _____

Abandoned _____

Date

APR 19 1940 19

S. J. LEWIS Scout

KANSAS

Pool Name Virgil

Map No. 17 Sec. 22 Twp. 23 R. 13E

Well No. 11. C.N. Shambaugh "A"

Mid-Continent Petroleum Company

COMPLETED

Contractor

SW NE NE

SECTION PLAT

990 Ft. from N. Line

_____ Ft. from S. Line

990 Ft. from E. Line

_____ Ft. from W. Line

			6

Greenwood Cpunty

Location _____

Rig up _____

Drilling and Remarks:

Miss 1729
6 5/8" @ 1744
1500 acid
Pump 15 Rod

35' - 40'

RECORD

Cased _____ in., _____ ft.

Sand _____

Gas _____

Oil _____

Total Depth 1725

PRODUCTION

1st 24 hrs. Nat. _____

1st 24 hrs. after shot _____

Gas _____ Cu. Ft.

Dry Hole _____

Abandoned _____

Date

JUN 14 1944 19

S. J. LEWIS Scout