


Form 51-5M-3-35-Mid-West

Map No. KANSAS Sec. 36 Twp. 13 R. 15-W

Well No. #1 Dilliner Farm

Wolfe Creek et al Company

NORTH

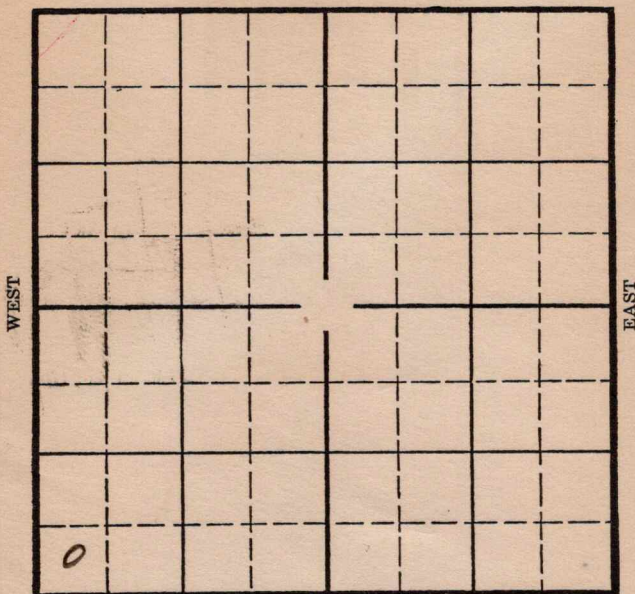

SOUTH

Location \_\_\_\_\_  
Drilling Remarks \_\_\_\_\_

Rig Up \_\_\_\_\_  
Drilling Remarks \_\_\_\_\_

\_\_\_\_\_  
\_\_\_\_\_  
RECORD

Cased \_\_\_\_\_ in. \_\_\_\_\_ ft.  
Sand \_\_\_\_\_  
Gas \_\_\_\_\_  
Oil \_\_\_\_\_  
Total Depth \_\_\_\_\_

PRODUCTION

1st 24 hrs. Nat. \_\_\_\_\_  
1st 24 hrs. after shot \_\_\_\_\_  
Gas \_\_\_\_\_ cu. ft. \_\_\_\_\_  
Dry Hole \_\_\_\_\_  
Abandoned \_\_\_\_\_



Map No. 72 Sec. 36 Twp. 13 R. 15W

Well No. 1 - Dilliner

Walfe Creek et al Company

Contractor

# FIRST REPORT

## SECTION PLAT

Ft. from N. Line

330 Ft. from S. Line

Ft. from E. Line

330 Ft. from W. Line

|   |  |  |  |
|---|--|--|--|
|   |  |  |  |
|   |  |  |  |
|   |  |  |  |
|   |  |  |  |
| 0 |  |  |  |

Location

Rig up

Drilling and Remarks:

*B.R.*

## RECORD

Cased in, ft.

Sand

Gas

Oil

Total Depth

## PRODUCTION

1st 24 hrs. Nat.

1st 24 hrs. after shot

Gas Cu. Ft.

Dry Hole

Abandoned

Date

FEB 26 1936

192

ORVAL MANNSCHRECK

Scout

KANSAS

Map No. 72 Sec. 36 Twp. 19 R. 15N

Well No. 1 Telliner

Waffle Creek Company

Contractor

SECTION PLAT

.....Ft. from N. Line

330 Ft. from S. Line

.....Ft. from E. Line

330 Ft. from W. Line

ABANDONED

|   |  |  |  |
|---|--|--|--|
|   |  |  |  |
|   |  |  |  |
|   |  |  |  |
|   |  |  |  |
| 0 |  |  |  |

Location.....

Rig up.....

Drilling and Remarks:

Sil 3318.

THA

RECORD

Cased.....in., .....ft.

Sand.....

Gas.....

Oil.....

Total Depth 3329

PRODUCTION

1st 24 hrs. Nat.....

1st 24 hrs. after shot.....

Gas.....Cu. Ft.

Dry Hole.....

Abandoned.....

Date

MAY 6 1936

192

S. J. LEWIS

Scout