


Russell

Section 36 Township 13 Range 15-W

Well No. #1 Dillner

Company Skelly

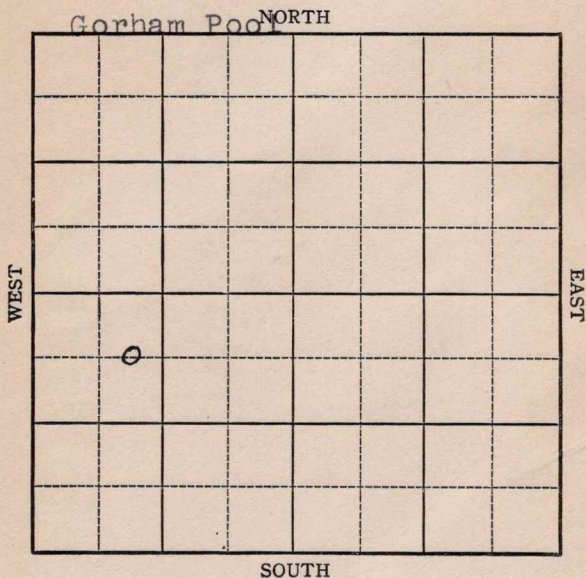

KANSAS Russell

Sec. 36 Twp. 13 R. 15-W

Well No. #1 Dillner Farm

Skelly Company

(Gorham Pool)


660 Ft. from N. Line

Ft. from S. Line

Ft. from E. Line

990 Ft. from W. Line

Elev. 1883

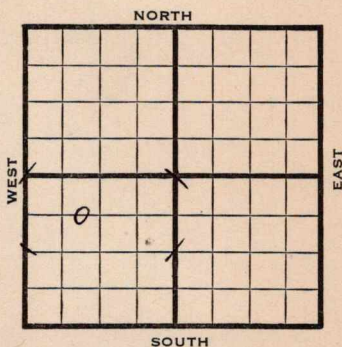

1942

REPORT

8/19 Location

8/27 10" @ 308 WOC

9/2 Drlg. 2145'

9/9 Drlg 3058

9/16 **Lans 3053 Arb 3304-06**

TD 6" @ 3304 $\frac{1}{2}$ Rust.

9/23 T.D. 3308' pump 116 Oil and 8 water
16 hours S.D.

9/30 " " " " "

10/7 " " " " "

10/14 " " " " "

10/21 **Arb. 3304** 6" @ 3304 $\frac{1}{2}$

T.D. 3308


Pump 70 oil plus 4% water Pot.

Gravity 36.2

COMPLETED

Map No. 72 Sec. 36 Twp. 13 R. 15WWell No. 1 DillnerSkelly Company
FIRST REPORT
ContractorC EL NW SW
660 Ft. from N. Line
Ft. from S. Line
Ft. from E. Line
990 Ft. from W. Line

SECTION PLAT

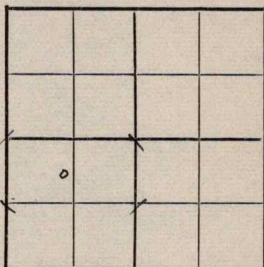

GORHAM POOL

Location XXX

Rig up

Drilling and Remarks:

RECORD

Cased _____ in., _____ ft.

Sand _____

Gas _____

Oil _____

Total Depth _____

PRODUCTION

1st 24 hrs. Nat. _____

1st 24 hrs. after shot _____

Gas _____ Cu. Ft.

Dry Hole _____

Abandoned _____

Date

AUG 19 1942 19S. J. LEWIS Scout

Russell

KANSAS

Map No. 72 Sec. 36 Twp. 13 R. 15WWell No. 1 DillnerSkelly

Company

COMPLETED

Contractor

C EL NW SW

660

Ft. from N. Line


Ft. from S. Line

Ft. from E. Line

990

Ft. from W. Line

SECTION PLAT

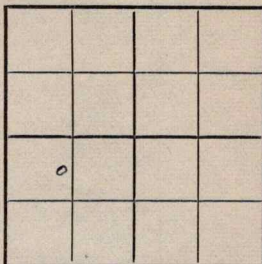

GORHAM POOL

Location

Rig up

Drilling and Remarks:

Per 33046" @ 3304 1/2Pump 70 oil Plus
4% Water & S.36 1/2 Gr

RECORD

Cased _____ in., _____ ft.

Sand _____

Gas _____

Oil _____

Total Depth 3308

PRODUCTION

1st 24 hrs. Nat. _____

1st 24 hrs. after shot _____

Gas _____ Cu. Ft.

Dry Hole _____

Abandoned _____

Date

OCT 21 194219S. J. LEWIS Scout