

KANSAS

Section 22 Township 23S Range 13E

Well No. #12, C.R. Shambaugh "A"


Company Mid-Continent Petroleum Corp.

~~Location Notice Only~~

NORTH

WEST

EAST

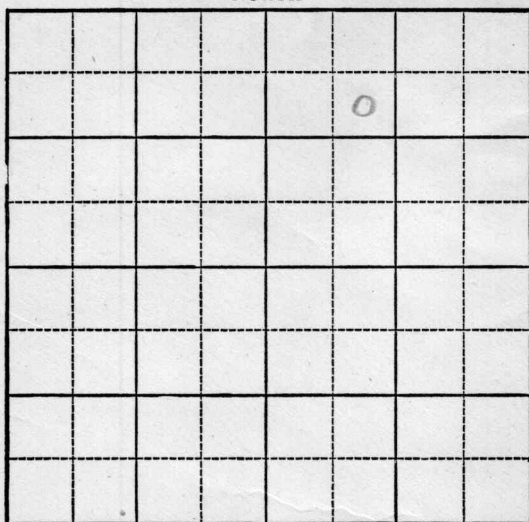

SOUTH

KANSAS

Greenwood County

Sec. 22 Twp. 23 R. 18 E

Well No. #12 C. N. Shambough "A" Farm

Mid-Continent Pet. Corp. Company

Virgil

NORTH

990 Ft. from N. Line

Ft. from S. Line

Ft. from E. Line

990 Ft. from W. Line

SOUTH

REPORT

1944

7/19 Rotary
7-26 10" at 23'
Drilling 1500'
8-2 Miss 1734'-42' TD
7" at 1738'
RUST

~~8/16~~ ~~Arb 3650 1/2~~
~~5" @ 3651~~
~~TD 3669~~

~~ABANDONED~~

8/16 Miss 1734
7" @ 1738
2000 Acid
TD 1772
Pump 4 Pot
Gravity 36.4

COMPLETED

KANSAS

Pool Name VirgilMap No. 17 Sec. 22 Twp. 23 R. 13EWell No. 12 C. N. Shambaugh "A"Mid-Continent Pet. Corp. Company

FIRST REPORT

Contractor

SE NW NE

SECTION PLAT

990 Ft. from N. Line Ft. from S. Line Ft. from E. Line990 Ft. from W. Line

		o	

Greenwood CountyLocation Rig up

Drilling and Remarks:

Rotary

RECORD

Cased in., ft.Sand Gas Oil Total Depth

PRODUCTION

1st 24 hrs. Nat. 1st 24 hrs. after shot Gas Cu. Ft.Dry Hole Abandoned

Date

JUL 1 9 1944 19S. J. LEWIS Scout

KANSAS

Pool Name Virgil PoolMap No. 17 Sec. 22 Twp. 23 R. 13EWell No. 12 C. N. Shambaugh "A"~~Mid-Continent Pet.~~ Company~~COMPLETED~~

Contractor

SE NW NE

SECTION PLAT

990 Ft. from N. Line Ft. from S. Line Ft. from E. Line990 Ft. from W. Line

		6	

GreenwoodLocation Rig up

Drilling and Remarks:

*Misc 1734**7" C 1738**2000 acid**Pump 4 P2**36 1/2*

RECORD

Cased in., ft.Sand Gas Oil Total Depth 1722

PRODUCTION

1st 24 hrs. Nat. 1st 24 hrs. after shot Gas Cu. Ft.Dry Hole Abandoned

Date

AUG 16 1944

19

S. J. LEWIS

Scout