


Map No. \_\_\_\_\_ Sec. 23 Twp. 23 R. 13

Well No. 1-Baker Farm \_\_\_\_\_  
Marshall Oil Company

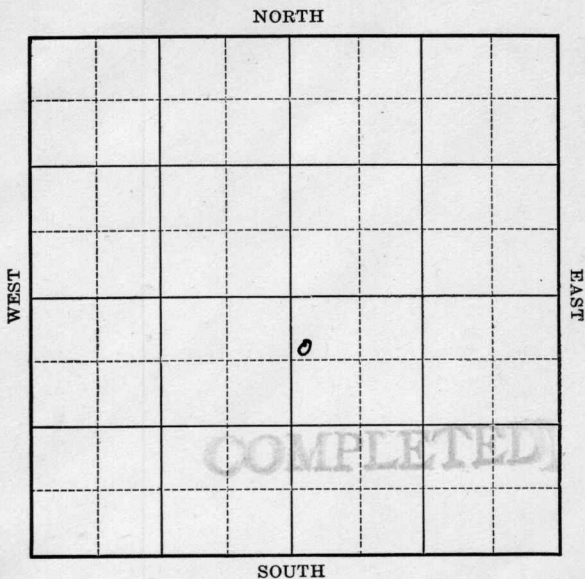

Location \_\_\_\_\_

Drilling Remarks:

-----

-----

**RECORD**

Cased \_\_\_\_\_ in. \_\_\_\_\_ ft.

Sand \_\_\_\_\_

Gas \_\_\_\_\_

Oil \_\_\_\_\_

Total Depth \_\_\_\_\_

Rig Up \_\_\_\_\_

Drilling Remarks:

-----

-----

**PRODUCTION**

1st 24 hrs. Nat. \_\_\_\_\_

1st 24 hrs. after shot \_\_\_\_\_

Gas \_\_\_\_\_ cu. ft.

Dry Hole \_\_\_\_\_

Abandoned \_\_\_\_\_

Map No. \_\_\_\_\_ Sec. 23 Twp. 23 R. 13


Well No. 1 Bahr Farm \_\_\_\_\_  
Marshall Oil Company

600 Ft. from N. Line

\_\_\_\_\_ Ft. from S. Line

\_\_\_\_\_ Ft. from E. Line

200 Ft from W. Line

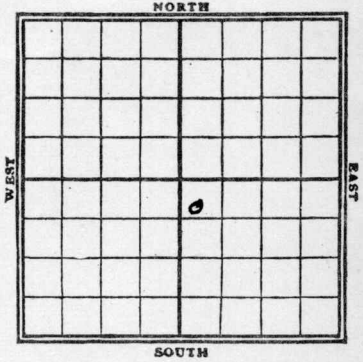

Date 9/10

REPORT

390-406

Map No. ~~K#7~~ <sup>No Map</sup> Sec. 23 Twp. 23 R. 13

Well No. 1 <sup>Bahr</sup>

Marshall Oil Company

Contractor

SECTION PLAT

600 Ft. from N. Line

Ft. from S. Line

Ft. from E. Line

200 Ft. from W. Line

		0	

FIRST REPORT

COMPLETED

Location

Rig up

Drilling and Remarks:

RECORD

Cased in., ft.

Sand

Gas 390-406

Oil

Total Depth

PRODUCTION

1st 24 hrs. Nat.

1st 24 hrs. after shot

Gas 2,000,000 Cu. Ft.

Dry Hole

Abandoned

Date

9/10 1912

Pyle Scout