


Section 9 Township 27 Range 6EWell No. #13 McGinnisCompany Saco Oil

NORTH

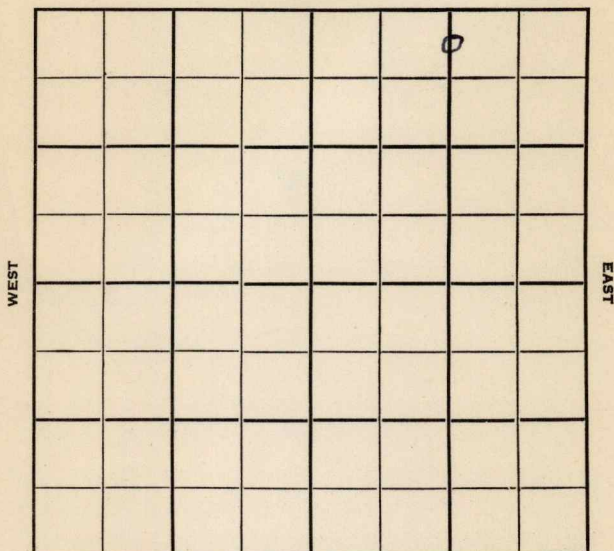

SOUTH

Butler

KANSAS

Sec. 9 Twp. 27 R. 6E ✓

Well No. #13 McGinnis Farm

Saco Oil Company

H & M Drlg. - Contr. Contractor

Shaffer Pool


330' Ft. from N. Line

_____ Ft. from S. Line

1320' Ft. from E. Line

_____ Ft. from W. Line

C N L N $\frac{1}{2}$ NE

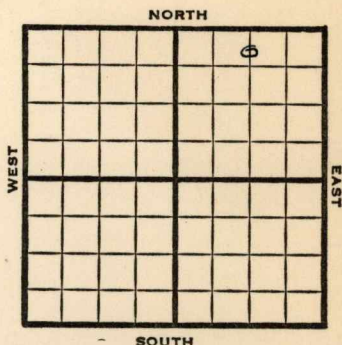

1950

Elev 1413' REPORT

12/6

Spud 12-1-50
Drlg. 550'

1951

1/10

Spud 12-1-50
13" @ 795
10" @ 1640
8" @ 2402
Miss 2759
7" @ 2761
Viola 3128
5" @ 3128
TD 3130
Comp 35 bopd
Completed

COMPLETED

County Butler State KansasSec. 9 (Blk.) 27 (Sur.) 6E Map No.Operator Saco OilWell No. 13 Farm McGinnisElev. Location C NL N $\frac{1}{2}$ NE

330 Ft. From N Line NE1320 Ft. From E Line Quarter1st. Report DEC 6 1950

Completion

Remarks

H & M Drlg. - Contr.Spudding Date 12-1-50Drlg. Data Shaffer Pooldrlg. 550

J. E. TYRA

County Butler State KansasSec. 9 (Blk.
Twp.) 27 (Sur.
Rge.) 6E Map No.Operator Saco OilWell No. 13 Farm McGinnisElev. 1413 Location C N L N $\frac{1}{2}$ NE

330 Ft. From N Line NE1320 Ft. From E Line Quarter

1st. Report

Completion JAN 10 1951Remarks Shaffer PoolH & M Drlg. - Contr.Spudding Date 12-1-50Drlg. Data Oil well TD 313013" @ 795 10" @ 1640 8" @ 2402Miss. 2759 7" @ 2761 Viola 31285" @ 3128 TD 3130 Comp. 35 bopd

J. E. TYRA