


Section 23 Township 23 Range 13E

Well No. #1 ~~Phan~~ Bahr

Company Hart & Barnett etal.
Virgil Pool



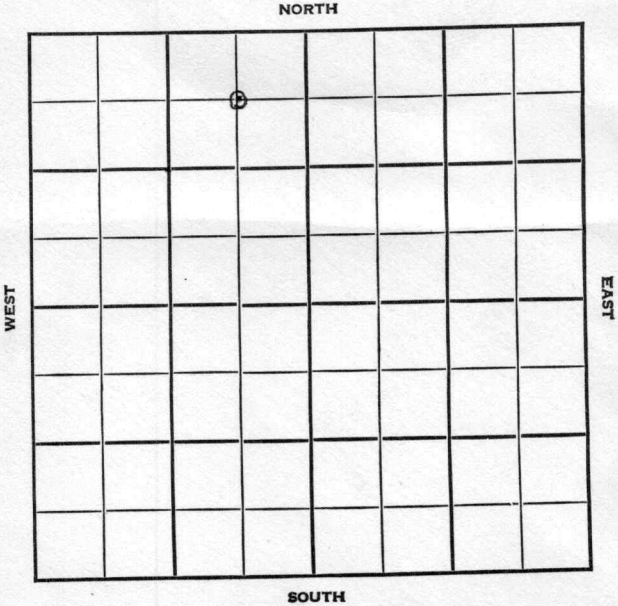

Sec. 23 Twp. 23 R. 13E

Well No. #1 Phar Baker Farm

Hart & Barnett et al Company


Virgil Pool

660' Ft. from N. Line

_____ Ft. from S. Line

660' Ft. from E. Line

_____ Ft. from W. Line

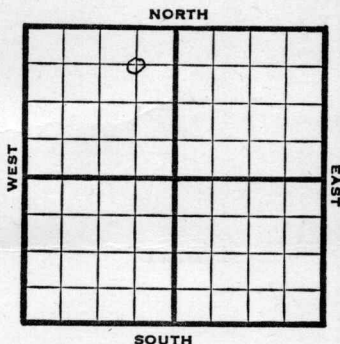

C NE NW

1948

REPORT

| | |
|------|-------------------------------------------------------------------------------|
| 3/24 | Machine |
| 3/31 | " |
| 4/7 | Drlg. 325' |
| 4/14 | 10" @ 675' Drlg. 860' |
| 4/21 | " |
| 4/28 | Drlg. 1510' |
| 5/4 | " |
| 5/12 | " |
| 5/19 | Mississippi 1765' TD 1782' 5" @ 1780' |
| 5/26 | " |
| 6/1 | " |
| 6/9 | Miss. 1765' 5" @ 1780' Pump 25 Pot oil 38.0 Gr. TD 1807' Comp. |

COMPLETED

Map No. _____ Sec. 23 Twp. 23 R. 13E

Well No. 1 Phar

Hart & Barnett etal. Company

FIRST REPORT

Contractor

C NE NW

SECTION PLAT

660 Ft. from N. Line

_____ Ft. from S. Line

660 Ft. from E. Line

_____ Ft. from W. Line

| | | | |
|--|---|--|--|
| | o | | |
| | | | |
| | | | |
| | | | |

Woodson County

RECORD

Location _____

Cased _____ in., _____ ft.

Rig up _____

Sand _____

Drilling and Remarks:

Gas _____

Oil _____

Machine

Total Depth _____

PRODUCTION

1st 24 hrs. Nat. _____

1st 24 hrs. after shot _____

Gas _____ Cu. Ft.

Dry Hole _____

Abandoned _____

Date

MAR 24 1948 19

S. J. LEWIS Scout

Map No. 17 Sec. 23 Twp. 23 R. 13E

Well No. 1 Bahr

Hart, Barnett etal. Company

CORRECTION Contractor

C NE NW

SECTION PLAT

660 Ft. from N. Line

_____ Ft. from S. Line

660 Ft. from E. Line

_____ Ft. from W. Line

| | | | |
|--|---|--|--|
| | o | | |
| | | | |
| | | | |
| | | | |
| | | | |

Woodson County

Location _____

Rig up _____

Drilling and Remarks:

Reported as

#1 Phar

RECORD

Cased _____ in., _____ ft.

Sand _____

Gas _____

Oil _____

Total Depth _____

PRODUCTION

1st 24 hrs. Nat. _____

1st 24 hrs. after shot _____

Gas _____ Cu. Ft.

Dry Hole _____

Abandoned _____

Date

MAR 31 1948

19

S. J. LEWIS

Scout

Map No. 17 Sec. 23 Twp. 23 R. 13E

Well No. 1 Bahr

Hart, Barnett etal. Company

COMPLETE Contractor

C NE NW

SECTION PLAT

| | | | |
|--|---|--|--|
| | o | | |
| | | | |
| | | | |
| | | | |

660 Ft. from N. Line

_____ Ft. from S. Line

660 Ft. from E. Line

_____ Ft. from W. Line

Woodson County

Location _____

Rig up _____

Drilling and Remarks:

Misc 1765.

5" @ 1750

Pump 25 P. Oil

35° Sg

RECORD

Cased _____ in., _____ ft.

Sand _____

Gas _____

Oil _____

Total Depth 1807

PRODUCTION

1st 24 hrs. Nat. _____

1st 24 hrs. after shot _____

Gas _____ Cu. Ft.

Dry Hole _____

Abandoned _____

Date

JUN 9 1948 19

S. J. LEWIS Scout