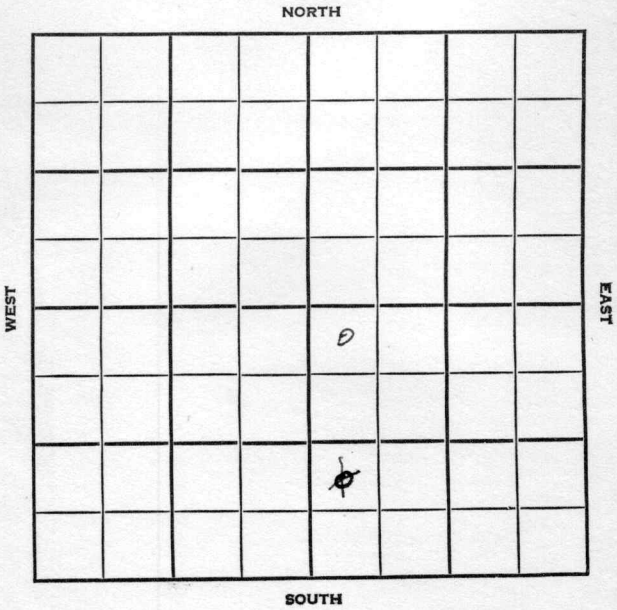


Section 23 Township 23 Range 13EWell No. 1 BahrCompany Lucky Seven Oil Co. (KC. Mo.)

Woodson KANSAS

SEC. 23	TWP. 23	R. 13E
---------	---------	--------

WELL NO. FARM

1 Bahr

COMPANY

Lucky Seven Oil Co.

CONTRACTOR


White & Ellis-Contr
N. Virgil Pool

330 Ft. from N. Line

990 Ft. from S. Line

_____ Ft. from E. Line

330 Ft. from W. Line

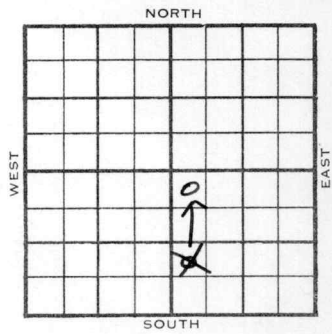

~~NW NW SE~~
~~NW SW SE~~

ELEVATION	REPORT
-----------	--------

1954	
6/15	MIR
7/28	Spdg 6-15-54 Oil well TD 2700 Lans. 689 KC 962 Bart. 1657 Miss. 1767 Viola 2165 Simp. 2181 Arb. 2187 TD 2700 5" @ 2240 30/2194-2201 FU 950' oil 30' wtr. 11 hr. Comp. 31 bopd 10 bw

COMPLETED

J. G. McGEHEE

Kansas

Map No. _____ Sec. 23 Twp. 23 R. 13EWell No. 1 BahrLucky Seven Oil Co. Company**CORRECTION**

Contractor

NW NW SE

SECTION PLAT

330 Ft. from N. Line

_____ Ft. from S. Line

_____ Ft. from E. Line

330 Ft. from W. Line

		0	

Woodson County

Location _____

Rig up _____

Drilling and Remarks:

Reported

NW SW SE

RECORD

Cased _____ in., _____ ft.

Sand _____

Gas _____

Oil _____

Total Depth _____

PRODUCTION

1st 24 hrs. Nat. _____

1st 24 hrs. after shot _____

Gas _____ Cu. Ft.

Dry Hole _____

Abandoned _____

Date

JUN • 3 • 1954J. G. McGEHEE

Scout

County Woodson State Kansas

Sec. 23 (Blk. Twp.) 23 (Sur. Rge.) 13E Map No.

Operator Lucky Seven Oil Co.

Well No. 1 Farm Bahr

Elev.	Location	NW	NW	SE
-------	----------	----	----	----

COMPLETE

0

330Ft. From N Line SE

330 Ft. From W Line Quarter

1st. Report

Completion **JUL 28 1954**

Remarks N. Virgil Pool

White & Ellis - Contr.

Spudding Date 6-15-54

Drlg. Data Oil well TD 2700

Lans. 689 KC 962 Bart. 1657

Miss. 1767 Viola 2165 Simp. 2181

Arb. 2187 TD 2700 5" @ 2240

30/ 2194-2201 FU 950' oil 30' wtr.

11 hr. Comp. 31 bopd 10bw

J. G. McGEHEE