


Map No. **KANSAS** Sec. 9 Twp. 27 R. 6^E

Well No. 7 - McGinnis Farm

Allison Fitzwilliams Company

NORTH

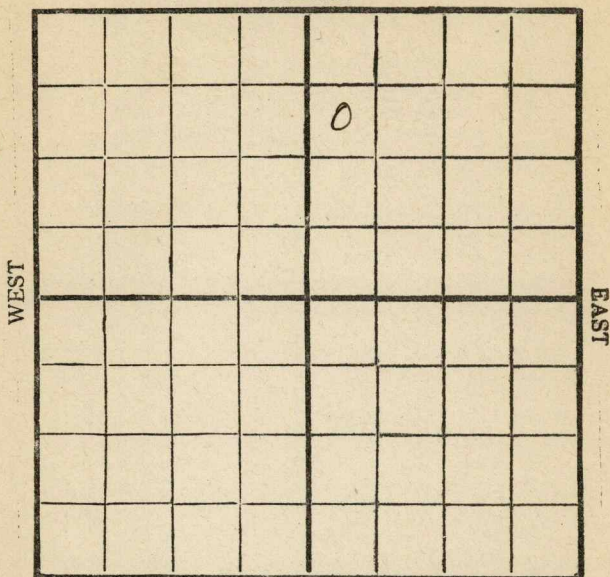

SOUTH

Location _____

Drilling Remarks

RECORD

Cased _____ in. _____ ft.

Sand _____

Gas _____

Oil _____

Total Depth _____

Rig Up _____

Drilling Remarks

PRODUCTION

1st 24 hrs. Nat. _____

1st 24 hrs. after shot _____

Gas _____ cu. ft. _____

Dry Hole _____

Abandoned _____

Map No. **KANSAS** Sec. 9 Twp. 27 R. 6^E

Well No. 7 Mc Ginnis Farm


Allison - Fitzwilliams Company

990 Ft. from N. Line

_____ Ft. from S. Line

_____ Ft. from E. Line

330 Ft. from W. Line

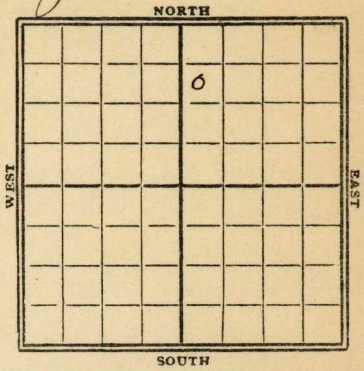

1929

Date REPORT

8/7 2364 Rig
8/14 Rig up.
8/21 Oil 9400
8/28 Oil 720
9/4 " 1220
9/11 " 1755
9/18 " 2200
9/24 Top line 2758'
10/2 Pay 2768-96'
swab 60 bbls oil
10/9
10/16 Top line 2758',
Oil 2768-96'
T.D. 2796'
60 bbls oil
Damp.

11 **KANSAS** Butler
 Map No. _____ Sec. 9 Twp. 27 R. 6 E
 Well No. 7 Mc Ginnis
Alison Fitzwilliams Company
 _____ Contractor

FIRST REPORTS

990 Ft. from N. Line
 _____ Ft. from S. Line
 _____ Ft. from E. Line
330 Ft. from W. Line

SECTION PLAT

		0	

Location _____

Rig up _____

Drilling and Remarks:

Bldg Rig

RECORD

Cased _____ in., _____ ft.

Sand _____

Gas _____

Oil _____

Total Depth _____

PRODUCTION

1st 24 hrs. Nat. _____

1st 24 hrs. after shot _____

Gas _____ Cu. Ft.

Dry Hole _____

Abandoned _____

Date

AUG 7 1929**CHAS. L. SHERWOOD**

192 _____ Scout

Butler

KANSAS

Map No. 77 Sec. 9 Twp. 27 R. 6

Well No. 7 Mc Ginnis

allison Fitzwilliams Company

Contractor

COMPLETE**SECTION PLAT**990 Ft. from N. Line

Ft. from S. Line

Ft. from E. Line

330 Ft. from W. Line

		0	

Location

Rig up

Drilling and Remarks:

Tap time 275860 lbs.**RECORD**

Cased _____ in., _____ ft.

Sand 2768-2796'

Gas _____

Oil _____

Total Depth 2796'**PRODUCTION**

1st 24 hrs. Nat. _____

1st 24 hrs. after shot _____

Gas _____ Cu. Ft.

Dry Hole _____

Abandoned _____

Date

OCT 16 1929**CHAS. L. SHERWOOD**

192____ Scout