


Section 9 Township 27 Range 6-E

Well No. #10 McGinnis

Company Hugo Oil

NORTH **Miscellaneous**

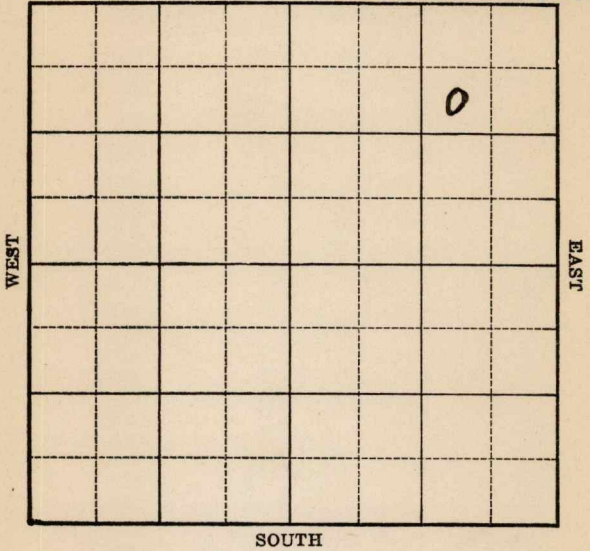

Map No. // Sec. 9 Twp. 27 R. 6E

Well No. 10 McGinnis

Hugo Oil Company

Contractor

FIRST REPORT

SW NE NE

990 Ft. from N. Line

Ft. from S. Line

990 Ft. from E. Line

Ft. from W. Line

SECTION PLAT

			o

MISCELLANEOUS

Location

Rig up

Drilling and Remarks:

12" - 715

10" - 1625

8" - 2251

Drlg. 2510

RECORD

Cased in., ft.

Sand

Gas

Oil

Total Depth

PRODUCTION

1st 24 hrs. Nat.

1st 24 hrs. after shot

Gas Cu. Ft.

Dry Hole

Abandoned

Date

JUL 5 1939 19

S. J. LEWIS

Scout

Map No. 11 Sec. 9 Twp. 27 R. 6E

Well No. 10 McGinnis

Hugo Oil Company

Contractor

COMPLETED

SW NE NE

990 Ft. from N. Line

_____ Ft. from S. Line

990 Ft. from E. Line

_____ Ft. from W. Line

SECTION PLAT

			o

MISCELLANEOUS

Location _____

Rig up _____

Drilling and Remarks:

Miss 2759

7" @ 2759

30000 cu ft

25 8/16 20% Water

RECORD

Cased _____ in., _____ ft.

Sand _____

Gas _____

Oil _____

Total Depth 2786 1/2

PRODUCTION

1st 24 hrs. Nat. _____

1st 24 hrs. after shot _____

Gas _____ Cu. Ft.

Dry Hole _____

Abandoned _____

Date

JUL 26 1939 19

S. J. LEWIS

Scout