


KANSAS

Butler county,

Section 9 Township 27 Range 6-E

Well No. #11, McGinnia

Company Saco Oil

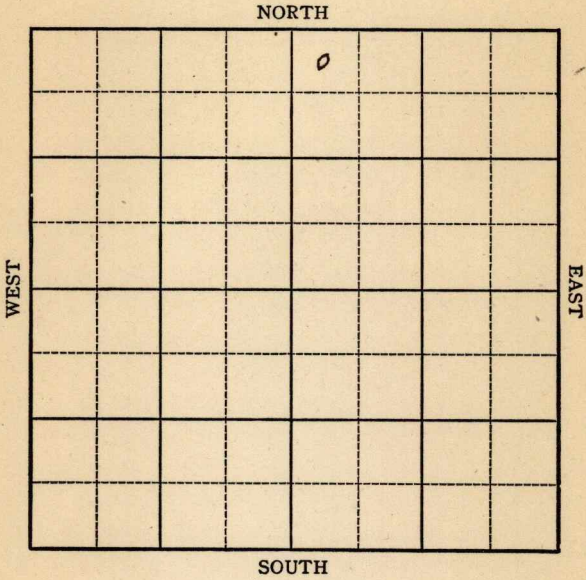

Sec. 9 Twp. 27 R. 6-E

Well No. #11, McGinnis Farm \_\_\_\_\_

Saco Oil Company \_\_\_\_\_

Miscellaneous


300' Ft. from N. Line

\_\_\_\_\_ Ft. from S. Line

\_\_\_\_\_ Ft. from E. Line

430' Ft. from W. Line

NW NE

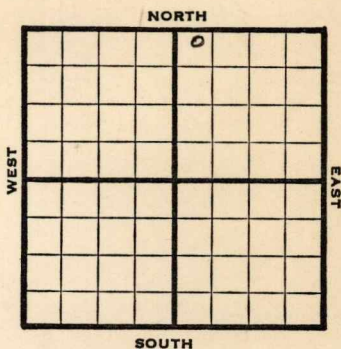

1946

**Elev. 1421'**

REPORT

10/2 Machine

10/8 Spud 135'

10/15 12" @ 766' WOC

10/22 10" @ 1629'

Drlg 1635'

10/29 **Lans 1806**

Drlg 2245'

11/6 **KC 2126'**

8" @ 2250'

Drlg 2760'

11/12 **Miss 2765**

7" @ 2765'

Drlg 2990'

11/20 Drlg 3005'

11/27 5" @ 3120', WOC

12/3 **Viola 3144-46 TD**

6 oil PH 4 hrs

12/11 **Viola 3144'**

5" @ 3120'

TD 3146'

500 Acid

Pump 35 oil plus 80% W Pot

Grav. 38

**COMPLETED**

**KANSAS** Kansas Pool Name Miscellaneous

Map No.     Sec. 9 Twp. 27 R. 6E

Well No. 11 McGinnis

Saco Oil Company

**FIRST REPORT** Contractor

NW NE

**SECTION PLAT**

300 Ft. from N. Line

    Ft. from S. Line

    Ft. from E. Line

430 Ft. from W. Line

		0	

Butler County

Location    

Rig up    

Drilling and Remarks:

Machine

**RECORD**

Cased     in.,     ft.

Sand    

Gas    

Oil    

Total Depth    

**PRODUCTION**

1st 24 hrs. Nat.    

1st 24 hrs. after shot    

Gas     Cu. Ft.

Dry Hole    

Abandoned    

Date

OCT 2 1946 19

S. J. LEWIS Scout

Kansas

Map No. \_\_\_\_\_ Sec. 9 Twp. 27 R. 6E

Well No. 11 McGinnis

Saco Oil Company

**COMPLETED**

Contractor

NW NE

*E. 1, 1421*

SECTION PLAT

		6	

300 Ft. from N. Line

\_\_\_\_\_ Ft. from S. Line

\_\_\_\_\_ Ft. from E. Line

430 Ft. from W. Line

Butler County

Location \_\_\_\_\_

Rig up \_\_\_\_\_

Drilling and Remarks:

*Vib 8144*

*5" @ 3/20*

*500 acid*

*Pump 25 oil + 80% W*

*BT*

*38° SW*

RECORD

Cased \_\_\_\_\_ in., \_\_\_\_\_ ft.

Sand \_\_\_\_\_

Gas \_\_\_\_\_

Oil \_\_\_\_\_

Total Depth 3146

PRODUCTION

1st 24 hrs. Nat. \_\_\_\_\_

1st 24 hrs. after shot \_\_\_\_\_

Gas \_\_\_\_\_ Cu. Ft.

Dry Hole \_\_\_\_\_

Abandoned \_\_\_\_\_

Date

DEC 1 1 1946 19

S. J. LEWIS Scout