

Section 9 Township 27 Range 6E

Well No. 12 McGinnis

Company Saco Oil

Misc.

NORTH

							0

WEST

EAST

SOUTH

KANSAS

Butler



Sec. 9 Twp. 27 R. 6E

Well No. #12 McGinnis Farm


Saco Oil

Company

Miscellaneous

NORTH

300' Ft. from N. Line

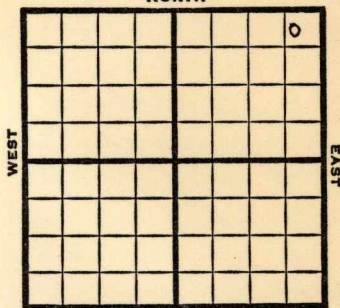

Ft. from S. Line

580' Ft. from E. Line

Ft. from W. Line

NE/C

SOUTH

1948

Elev 1402'

REPORT

12/15 Drlg. 1000'

12/22 12" @ 745'
Drlg. 1130'

12/29 10" @ 1630'
Drlg. 1835'

1/5 Drlg. 2545'

1/12 Lansing 1795 KC 2105
8" @ 2251 Mississippi 2745
7" @ 2745 Drlg 3000'

1/19 Viola 3125'
TD 3133'

1/26 5" @ 3125'
TD 3135
250 acid

2/2 2/9 " TD 3135'
Viola 3125'

5" @ 3125'
250 acid
Pump 15 oil Pot
380 Gr.

Comp

COMPLETED

Map No. _____ Sec. 9 Twp. 27 R. 6E

Well No. 12 McGinnis

Saco Oil Company

FIRST REPORT Contractor

NE/C

SECTION PLAT

300 Ft. from N. Line

_____ Ft. from S. Line

580 Ft. from E. Line

_____ Ft. from W. Line

			0

Butler County

Location _____

Rig up _____

Drilling and Remarks:

drlg. 100'

RECORD

Cased _____ in., _____ ft.

Sand _____

Gas _____

Oil _____

Total Depth _____

PRODUCTION

1st 24 hrs. Nat. _____

1st 24 hrs. after shot _____

Gas _____ Cu. Ft.

Dry Hole _____

Abandoned _____

Date

DEC 15 1948

19

S. J. LEWIS

Scout

Kansas

Miscellaneous

Map No. K 11 Sec. 9 Twp. 27 R. 6EWell No. 12 Mc GuinnisSaco Oil Company

COMPLETE

Contractor

NE 1/4E. 1402


SECTION PLAT

300 Ft. from N. Line

_____ Ft. from S. Line

550 Ft. from E. Line

_____ Ft. from W. Line

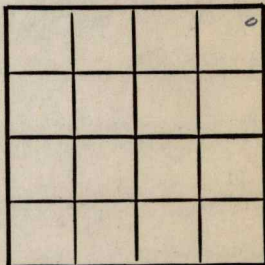Butter

RECORD

Location _____

Cased _____ in., _____ ft.

Rig up _____

Sand _____

Drilling and Remarks:

Gas _____

Vista 3125.

Oil _____

5" @ 3125Total Depth 3135.200 ac @

PRODUCTION

Pump 15 oil Oct

1st 24 hrs. Nat. _____

1st 24 hrs. after shot _____

Gas _____ Cu. Ft.

Dry Hole _____

Abandoned _____

350 cu

Date

FEB 9 1949 19

S. J. LEWIS Scout