


Section 9 Township 15 Range 13^WWell No. 1 RosnerCompany Bennett & Roberts

NORTH

WEST

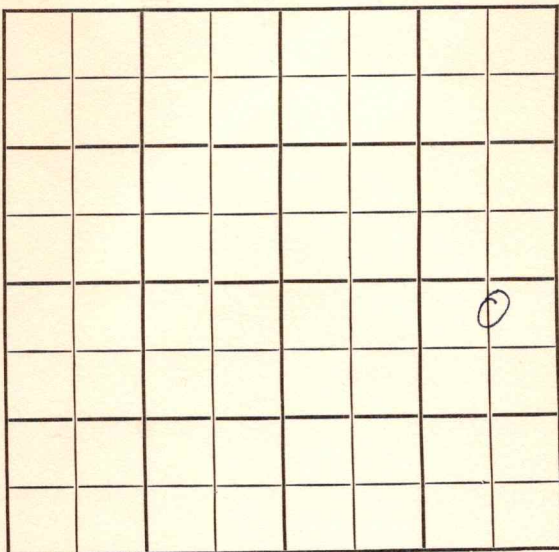

EAST

SOUTH

Russell

KANSAS

SEC.	TWP.	R.
9	15	13W
WELL NO.		

#1 Rosner FARM
COMPANY

Bennett & Roberts

CONTRACTOR

Trapp

Ft. from N. Line


Ft. from S. Line

Ft. from E. Line

Ft. from W. Line

C N $\frac{1}{2}$ NE SE

Phillips Farmout

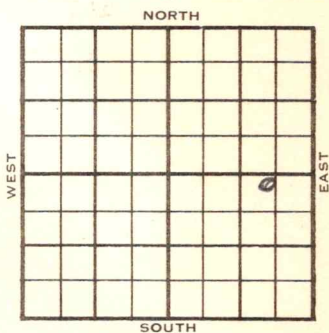

FIRST REPORT

1955

ELEVATION

1881'

REPORT

7/13

Loc

8/10

Comm 7-16-55

Tp 2748

H 2974

Dg 3006

L 3044

V. Gorham 3330

A 3343

TD 3345

8 5/8" @ 431 DST 3069 1/2 91 open

1 hr Rec 30' mud DST 3130-40 open 1

hr. Rec 1300' gas 200' ho & gcm 405#

TD 3345 5" @ 3344/100 CO to 3345

B/4 goph 500 A S/6 boph

Comp 25 bopd

COMPLETED

County Russell Elev. _____
 Sec. 9 Twp. 25 Rge. 13W
 Company Bennett & Roberts
 Farm Name Rosner No. 1

TOPS	DEPTH	LOG	DATUM	Loc. in Sec.
Anh.				C N $\frac{1}{2}$ NE SE
Tr.				
H.				
Tr.				
Dg.				
Bl.				
L.				Geol.
K.C.				Contr.
B.K.C.				
Ce.				
C.				Pool
M.				Trapp
M.				
K.				
Mz.				
Me.				
V.				
S.				
S.				
A.				
R.				
Pe.				
G.				
T.D.				

FIRST REPORT
 JUL 13 '35

Date Comm. Phillips farmout
 Location _____

12

County Russell Elev. 1881Sec. 9 Twp. 15 Rge. 13WCompany Bennett & RobertsFarm Name Rosner No. 1

TOPS DEPTH LOG DATUM

Anh.				Loc. in Sec. <u>C N$\frac{1}{2}$ NE SE</u>
TP.	<u>3748</u>		<u>867</u>	
H.	<u>2974</u>		<u>1093</u>	
Tr.				
Dg.	<u>3006</u>		<u>1125</u>	
BL.				
L.	<u>3044</u>		<u>1163</u>	Geol. _____
K.C.				Contr. _____
B.K.C.				
Ce.				
C.				
M.				
M.				Pool _____
K.				<u>Trapp</u>
Mz.				
Me.				
V. <u>Dorham</u>	<u>3330</u>		<u>1449</u>	COMPLETE
S.				
S.				
A.	<u>3343</u>		<u>1462</u>	
R.				
Pe.				
G.				
TD.	<u>3345</u>			

Date Comm. 7-16-55 AUG 10 19558 5/8" @ 431 DST 3069-91 open 1 hr.Rec. 30' mud DST 3130-40 open 1 hr.Rec. 1300' gas 200' ho & gcm 405#TD 3345 5" @ 3344/100 CO to 3345B/ 4 goph 500 A S/ 6 bophCompl 25 bopd