KANSAS

Form 51—5M—7-40—Palace


Butler

Section 9 Township 27 Range 6-E

Well No. #1 Tatum

Company O. J. Connell

Leon Pool

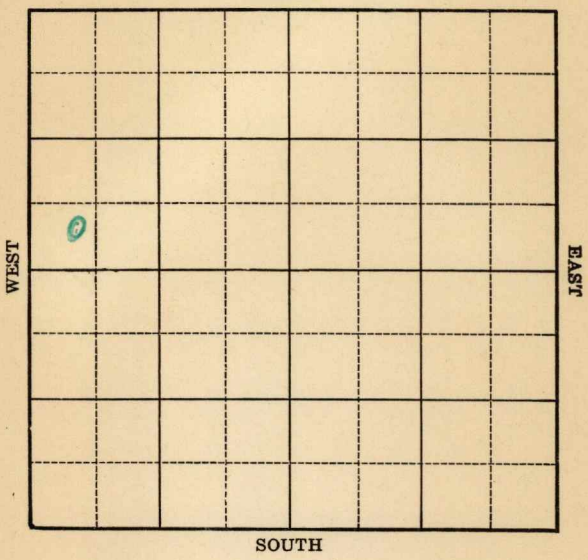

FORM 252-A 5M 7-40 PETROL KANSAS Butler

Sec. 9 Twp. 27 R. 6-E

Well No. #1 Tatum Farm

O. J. Connell Company


(Leon)

____ Ft. from N. Line

450 Ft. from S. Line

____ Ft. from E. Line

500 Ft. from W. Line

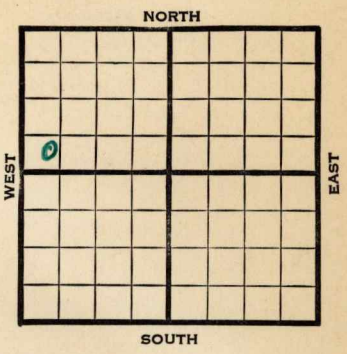

1940	REPORT
11/26	Rotary.
12/5	Machine. Spud 10'
12/12	Drlg. 580'
12/19	10" - 1647' Drlg. 1695'
12/26	Drlg. 1975'
1941	
1/2	Drlg. 2600'
1/9	8" - 2470' Miss. 2770'
	SSO 2785-87' ¼ B.W. 2830'
	Viola 3153-57' T.D. 5" - 3153'
1/16	" " " "
1/22	Viola 3153'
	5" - 3153'
	T.D. 3158'
	1000 acid.
	Pump 30 oil & 100 water.
	36. Gravity
	COMPLETED

Form 26—200 Bks.—1-40—Palace Butler KANSAS

Map No. // Sec. 9 Twp. 27 R. 6E

Well No. 1 Tatum

O. J. Connell Company

Contractor

FIRST REPORT

SW NW

_____ Ft. from N. Line


450 Ft. from S. Line

_____ Ft. from E. Line

500 Ft. from W. Line

LEON POOL

SECTION PLAT

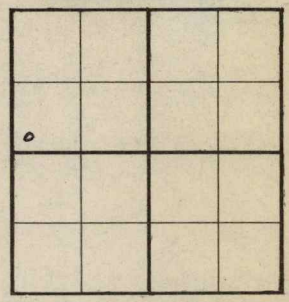

Location _____

Rig up _____

Drilling and Remarks:

Rotary

RECORD

Cased _____ in., _____ ft.

Sand _____

Gas _____

Oil _____

Total Depth _____

PRODUCTION

1st 24 hrs. Nat. _____

1st 24 hrs. after shot _____

Gas _____ Cu. Ft.

Dry Hole _____

Abandoned _____

Date

NOV 26 1940 19____

S. J. LEWIS Scout

Form 26—200 Bks.—1-40—Palace Butler KANSAS

Map No. 11 Sec. 9 Twp. 27 R. 6E

Well No. 1 Tatum

O. J. Connell Company

Contractor

COMPLETED

SW NW

Ft. from N. Line


450 Ft. from S. Line

Ft. from E. Line

500 Ft. from W. Line

LEON POOL

SECTION PLAT

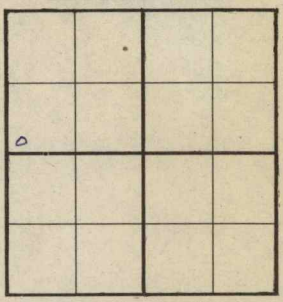

Location

Rig up

Drilling and Remarks:

Viola 3153

5" @ 3153

1000 acid

Pump 80 oil 100 Water

36° Gr

RECORD

Cased in., ft.

Sand

Gas

Oil

Total Depth 3158.

PRODUCTION

1st 24 hrs. Nat.

1st 24 hrs. after shot

Gas Cu. Ft.

Dry Hole

Abandoned

Date

JAN 22 1941 19

S. J. LEWIS Scout