


Map No. _____ Sec. 9 Twp. 27 R. 6 E

Well No. 2 - Tatum Farm _____

Phillips Petroleum Company

NORTH

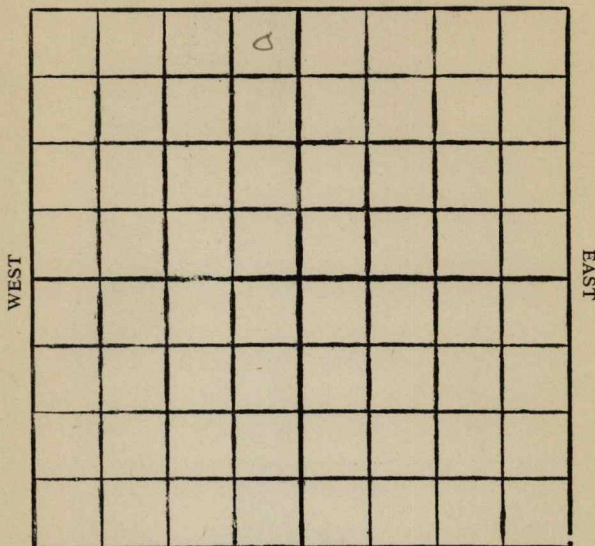

SOUTH

Location _____

Drilling Remarks _____

Rig Up _____

Drilling Remarks _____

RECORD

Cased _____ in. _____ ft.

Sand _____

Gas _____

Oil _____

Total Depth _____

PRODUCTION

1st 24 hrs. Nat. _____

1st 24 hrs. after shot _____

Gas _____ cu. ft.

Dry Hole _____

Abandoned _____


Butler

Map No. Kansas Sec. 9 Twp. 27 R 6^EWell No. 2 Tatum FarmPhillips Pet Company330 Ft. from N. Line

Ft. from S. Line

330 Ft. from E. Line

Ft. from W. Line

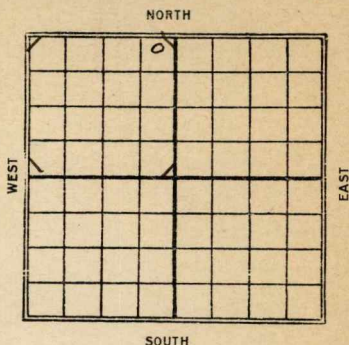

Date	REPORT
1927	
1/19	Reg bldg
1/16	Rigging up
2/3	Spudding
2/10	Drilg. 900
2/17	" 1565
4/24	" 1980
3/2	D. D. 2230
3/9	Drilg 2445
3/16	" 2870
3/24	sand 2762-95 - 75 bbl. show show oil in line 2840-45 + hole full water. Drilg 3020
3/30	Setting 5"-3140
4/7	Wilcox 3152-59 - T.D. 3178 H.F.W. - Will P.B. to sand 2762-95
4/13	sand 2762-95 - show oil + H.F.W. at 2840-45'
	Wilcox 3152-59 - H.F.W. 3178' - P.B. to sand 2762-95 - 100 bbls

Butler
 11 **KANSAS**
 Map No. _____ Sec. 9 Twp. 27 R. 6^E
 Well No. 2 Zatum
Phillips pet Co Company

Contractor

FIRST REPORTS**SECTION PLAT**

330 Ft. from N. Line

_____ Ft. from S. Line

330 Ft. from E. Line

_____ Ft. from W. Line

	0		

Location _____

Rig up Blog

Drilling and Remarks:

RECORD

Cased _____ in., _____ ft.

Sand _____

Gas _____

Oil _____

Total Depth _____

PRODUCTION

1st 24 hrs. Nat. _____

1st 24 hrs. after shot _____

Gas _____ Cu. Ft.

Dry Hole _____

Abandoned _____

Date

JAN 19 1927

CHAS. L. SHERWOOD


192

Scout

Butler

11 **KANSAS** Map No. Sec. 9 Twp. 27 R. 6Well No. 2 Datum
Phillips Pet Co Company

Contractor

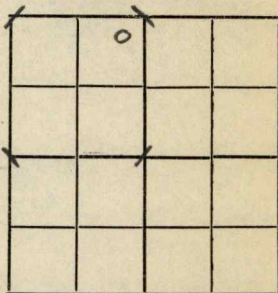COMPLETED**SECTION PLAT**

330 Ft. from N. Line

Ft. from S. Line

330 Ft. from E. Line

Ft. from W. Line

Location

Rig up

Drilling and Remarks:

Sand 2762-95
 show oil & NFW
 2840-45
 Wilcox 3152-59 NFW
 3178 P.B. to Sand
 Sand 2762-95
 100 Bls.

RECORD

Cased _____ in., _____ ft.

Sand _____

Gas _____

Oil _____

Total Depth 3178'

PRODUCTION

1st 24 hrs. Nat. _____

1st 24 hrs. after shot _____

Gas _____ Cu. Ft.

Dry Hole _____

Abandoned _____

Date

APR 13 1927

192

CHAS. L. SHERWOOD

Scout