


Section 23 Township 23 Range 13-E

Well No. #2 Bahr

Company H H Hart

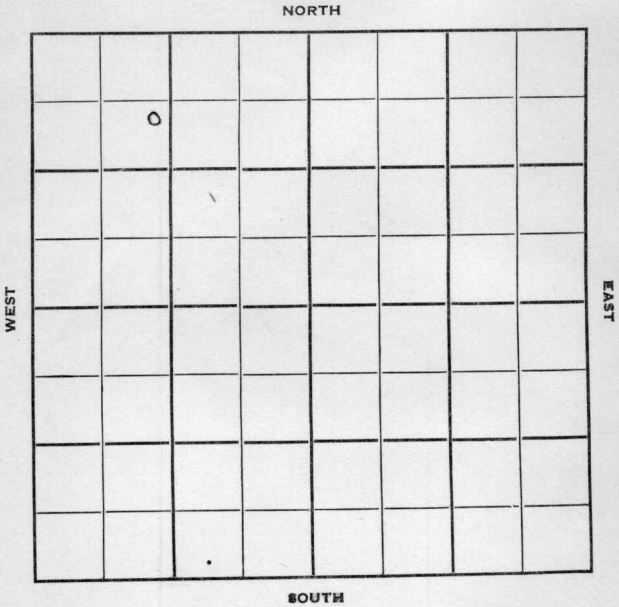

Sec. 23 Twp. 23 R. 13-E

Well No. #2 Bahr Farm

H. H. Hart Company


Contractor

700 Ft. from N. Line

Ft. from S. Line

Ft. from E. Line

1200 Ft. from W. Line  
of NW

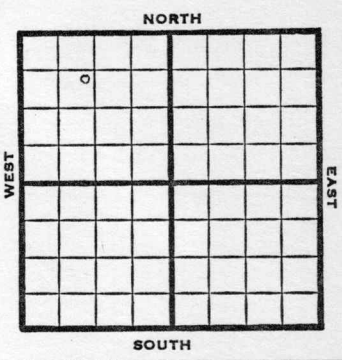

1950 Elev. - REPORT

5/24 Spud 5-22-50  
Drlg. 500

6/21 8" @ 735'  
Bart 1650-85 TD  
6" @ 1657  
50 qt/1660-85  
Comp. 28 BOPD & wtr.  
TD 1685'  
  
COMPLETED

Map No. \_\_\_\_\_ Sec. 23 Twp. 23 R. 13E

Well No. 2 Bahr

H. H. Hart Company

Contractor

SECTION PLAT

700 Ft. from N. Line

\_\_\_\_\_ Ft. from S. Line

\_\_\_\_\_ Ft. from E. Line

1200 Ft. from W. Line  
of NW

0			
FIRST		REPORT	

Woodson

Location \_\_\_\_\_

Rig up \_\_\_\_\_

Drilling and Remarks:

Spud 5-22-50

Drlg. 500

RECORD

Cased \_\_\_\_\_ in., \_\_\_\_\_ ft.

Sand \_\_\_\_\_

Gas \_\_\_\_\_

Oil \_\_\_\_\_

Total Depth \_\_\_\_\_

PRODUCTION

1st 24 hrs. Nat. \_\_\_\_\_

1st 24 hrs. after shot \_\_\_\_\_

Gas \_\_\_\_\_ Cu. Ft.

Dry Hole \_\_\_\_\_

Abandoned \_\_\_\_\_

Date

MAY 24 1950 19

J. E. TYRA Scout

Kansas

Map No. \_\_\_\_\_ Sec. 23 Twp. 23 R. 13E

Well No. 2 Bahr

H. H. Hart Company

Contractor

C E L NW NW

SECTION PLAT

700 Ft. from N. Line

\_\_\_\_\_ Ft. from S. Line

\_\_\_\_\_ Ft. from E. Line

1200 Ft. from W. Line



Woodson County MCPC NE of 23 N $\frac{1}{2}$  of 22

Location \_\_\_\_\_

Rig up \_\_\_\_\_

Drilling and Remarks:

8" @ 735  
 Bart. 1650-85 TD  
 6" @ 1657  
 50 qt/ 1660-85  
 Comp. 28 bopd  
 & water

RECORD

Cased \_\_\_\_\_ in., \_\_\_\_\_ ft.  
 Sand \_\_\_\_\_  
 Gas \_\_\_\_\_  
 Oil \_\_\_\_\_  
 Total Depth 1685

PRODUCTION

1st 24 hrs. Nat. \_\_\_\_\_  
 1st 24 hrs. after shot \_\_\_\_\_  
 Gas \_\_\_\_\_ Cu. Ft.  
 Dry Hole \_\_\_\_\_  
 Abandoned \_\_\_\_\_

Date

JUN 21 1950 19

J. E. TYRA Scout