
Form 51-10M-7-20-CroMac Kansas

Map No. ____ Sec. 23 Twp. 23 R. 13

Well No. 2 Hosley Baker Farm

Empire Gas & Fuel Company

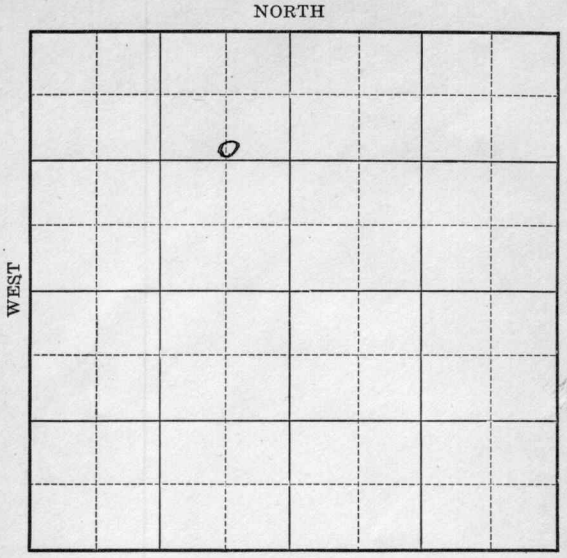

OWDD.

COMPLETED

Location _____ Rig Up _____

Drilling Remarks: Drilling Remarks:

RECORD

Cased _____ in. _____ ft.

Sand _____

Gas _____

Oil _____

Total Depth _____

PRODUCTION

1st 24 hrs. Nat. _____

1st 24 hrs. after shot _____

Gas _____ cu. ft.

Dry Hole _____

Abandoned _____

Form 252A 5M 4-22 8765

Map No. K Sec. 23 Twp. 23 R. 13

Well No. #2 Hesler Farm


Empire Gas Company

1120 Ft. from N. Line

Ft. from S. Line

660 Ft. from E. Line

Ft. from W. Line

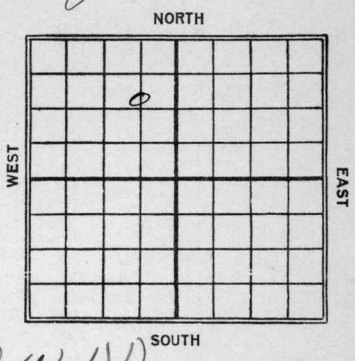

C. OWDD

Date 192	REPORT
7/22	Dlg 750'
8/19	Sand 1658-95 - Shot 90 qts. 20 Bbls.
1924	O. W. D. D.
12/11	Set 5" 1715'
8/14	Sand 1658-95 90/20 Bbls

Form 26—1M—4-19—Mid-West

Map No. Kans 17 Sec. 23 Twp. 23 R. 13

Well No. 2 Healy

Empire Gas & Fuel Company

Contractor

FIRST REPORT


1120 Ft. from N. Line

Ft. from S. Line

660 Ft. from E. Line

Ft. from W. Line

SECTION PLAT

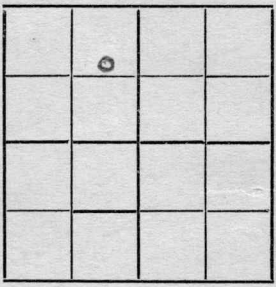

Location

Rig up

Drilling and Remarks:

Holy. 750'

RECORD

Cased in., ft.

Sand

Gas

Oil

Total Depth

PRODUCTION

1st 24 hrs. Nat.

1st 24 hrs. after shot

Gas Cu. Ft.

Dry Hole

Abandoned

Date

JUL 22 1922 191

M. A. BENEAR Scout

Form 26—1M—4-19—Mid-West

Map No. KN Sec. 23 Twp. 23 R. 13


Well No. 2 Hesler

Empire Gas & Fuel Company

Contractor

COMPLETED

SECTION PLAT

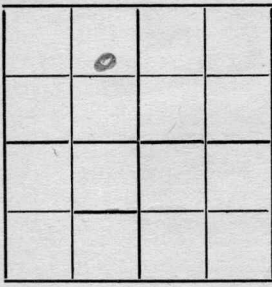

1120 Ft. from N. Line

Ft. from S. Line

660 Ft. from E. Line

Ft. from W. Line

Location

Rig up

Drilling and Remarks:

shot 90 qts.

RECORD

Cased in., ft

Sand 1658-95

Gas

Oil

Total Depth

PRODUCTION

1st 24 hrs. Nat.

1st 24 hrs. after shot 20

Gas Cu. Ft

Dry Hole

Abandoned

Date

AUG 19 1922

191

M. A. BENEAR

S

Form 26—1M Bks.—3-23—11959.

17 KANSAS

Map No. _____ Sec. 23 Twp. 23 R. 13


Well No. 2 Bahr

Empire Dr. 7 Company

_____ Contractor

FIRST REPORT

SECTION PLAT

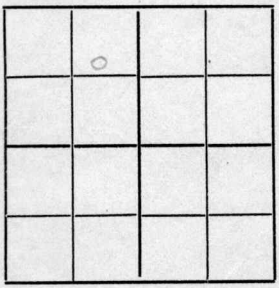

_____ Ft. from N. Line

_____ Ft. from S. Line

760 Ft. from E. Line

_____ Ft. from W. Line

Location _____

Rig up _____

Drilling and Remarks:

Old well
dly deepr
at 5" 1715

RECORD

Cased _____ in., _____ ft.

Sand _____

Gas _____

Oil _____

Total Depth _____

PRODUCTION

1st 24 hrs. Nat. _____

1st 24 hrs. after shot _____

Gas _____ Cu. Ft.

Dry Hole _____

Abandoned _____

Date

DEC 11 1924

_____ 192___.

M. A. BENEAR

_____ Scout

Form 26—1M Bks.—3-23—11959.

Map No. 17 KANSAS Sec. 23 Twp. 23 R. 13

Well No. 2 Hess Bd

Empire Nat Gas Co Company

Contractor

COMPLETED


1120 Ft. from N. Line

Ft. from S. Line

660 Ft. from E. Line

Ft. from W. Line

SECTION PLAT

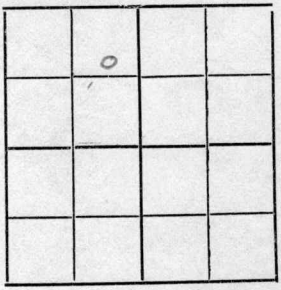

Location

Rig up

Drilling and Remarks:

90/20 bbls.

RECORD

Cased 1 in., 1 ft.

Sand 1658-1695

Gas

Oil

Total Depth 1695

PRODUCTION

1st 24 hrs. Nat.

1st 24 hrs. after shot

Gas Cu. Ft.

Dry Hole

Abandoned

Date

AUG 14 1925

192

CHAS. L. SHERWOOD

Scout