


Map No. **KANSAS** Sec. 10 Twp. 27 R. 6  
Well No. 3 - Marshall Farm  
Hixie Oil Co Company

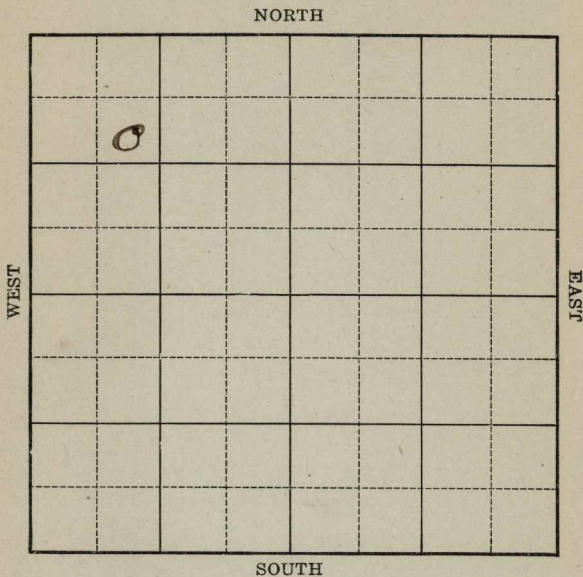

Location \_\_\_\_\_

Drilling Remarks \_\_\_\_\_

\_\_\_\_\_

\_\_\_\_\_

**RECORD**

Cased \_\_\_\_\_ in. \_\_\_\_\_ ft.

Sand \_\_\_\_\_

Gas \_\_\_\_\_

Oil \_\_\_\_\_

Total Depth \_\_\_\_\_

Rig Up \_\_\_\_\_

Drilling Remarks \_\_\_\_\_

\_\_\_\_\_

\_\_\_\_\_

**PRODUCTION**

1st 24 hrs. Nat. \_\_\_\_\_

1st 24 hrs. after shot \_\_\_\_\_

Gas \_\_\_\_\_ cu. ft.

Dry Hole \_\_\_\_\_

Abandoned \_\_\_\_\_

Map No. **KANSAS** Sec. 10 Twp. 27 R. 6

Well No. 3-Marshall Farm  
Blivie Oil Company


NORTH

990 Ft. from N. Line

\_\_\_\_\_ Ft. from S. Line

\_\_\_\_\_ Ft. from E. Line

990 Ft. from W. Line

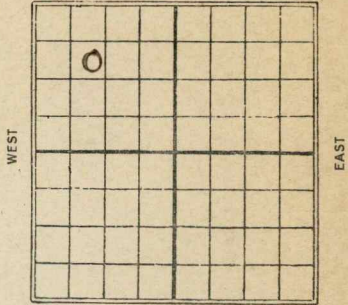

SOUTH

1928

Date

REPORT

Date	REPORT
7/13	Loc
7/19	Rigging up-
7/26	Drly 400.
8/2	" 1250
8/9	" 1840
8/16	" 2350
8/23	Top line 2740 Drly 2825
8/30	sand 3119-35 - T.D.
	T.L. 2740 - 3052
	40720 bbls
	Comp

Butler

MAP NO. R11 Kansas SEC. 10 TWP. 27 R. 6

WELL No. 3 Marshall  
Dixie Oil Co COMPANY

CONTRACTOR

SECTION PLAT

FIRST REPORTS

990 FT. FROM N. LINE  
\_\_\_\_ FT. FROM S. LINE  
\_\_\_\_ FT. FROM E. LINE  
990 FT. FROM W. LINE

0			

LOCATION ✓

RIG UP \_\_\_\_\_

DRILLING AND REMARKS:

*[Faded red text and scribbles in the drilling remarks section]*

RECORD

CASED \_\_\_\_\_ IN., \_\_\_\_\_ FT.  
SAND \_\_\_\_\_  
GAS \_\_\_\_\_  
OIL \_\_\_\_\_  
TOTAL DEPTH \_\_\_\_\_

PRODUCTION

1ST 24 HRS. NAT. \_\_\_\_\_  
1ST 24 HRS. AFTER SHOT \_\_\_\_\_  
GAS \_\_\_\_\_ CU. FT.  
DRY HOLE \_\_\_\_\_  
ABANDONED \_\_\_\_\_

DATE 7/13/28 Sheword SCOUT  
192

Butler

K 11 KANSAS

MAP NO. \_\_\_\_\_ SEC. 10 TWP. 27 R. 6

WELL NO. 3 Marshall

Dixie Oil Co

COMPANY

CONTRACTOR

COMPLETED

SECTION PLAT

0			

990 FT. FROM N. LINE

FT. FROM S. LINE

FT. FROM E. LINE

990 FT. FROM W. LINE

LOCATION \_\_\_\_\_

RIG UP \_\_\_\_\_

DRILLING AND REMARKS:

TL 2740-3052

407 20 Bb

RECORD

CASED 2 IN. 2135 FT.

SAND 2119-2135

GAS \_\_\_\_\_

OIL \_\_\_\_\_

TOTAL DEPTH 2136

PRODUCTION

1ST 24 HRS. NAT. \_\_\_\_\_

1ST 24 HRS. AFTER SHOT \_\_\_\_\_

GAS \_\_\_\_\_ CU. FT.

DRY HOLE \_\_\_\_\_

ABANDONED \_\_\_\_\_

DATE

AUG 30 1928

CHAS. L. SHERWOOD

192

SCOUT