


SECTION 28 - TOWNSHIP 19 RANGE 1W

WELL NO. #1 Bahar

COMPANY Geo. Hess & Louis Kahn

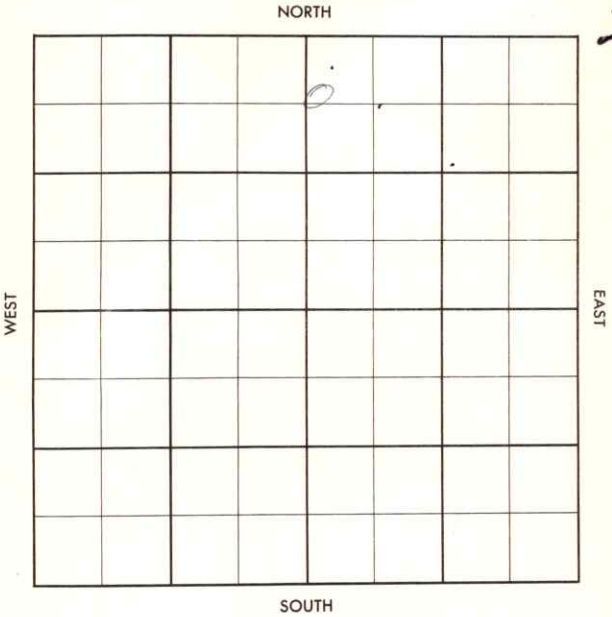

SEC. 28	TWP. 19	R. 1W
------------	------------	----------

WELL NO. #1 Bahar FARM

COMPANY Geo. Hess & Louis Kahn

CONTRACTOR Mallard


Ritz-Canton

_____ Ft. from N. Line

_____ Ft. from S. Line

_____ Ft. from E. Line

_____ Ft. from W. Line

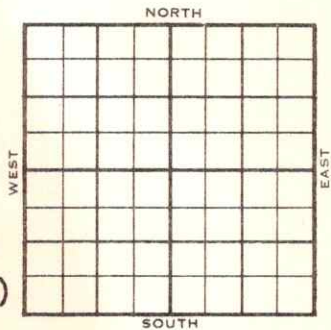

SW NW NW NE (TWIN WELL)

	ELEVATION	REPORT
--	-----------	--------

1956

1586'

5-23

Comm. 5-19-56
8" @ 157 w/90
Drlg. 1010

5-20

5 1/2" @ 2990 w.75

6-6

No report

6-13

No report

6-20

CO 2993

DD 3008 TD

\$ 5 bwph, PB 2983

65/ 2944-76

\$ 8 bwph / sso

D & A

M. 2917',

TD 2993'

ABANDONED

County McPherson Elev. 1586
 Sec. 28 Twp. 19 Rge. 1W
 Company Geo. Hess & Louis Kahn
 Farm Name Bahar No. 1

TOPS	DEPTH	LOG	DATUM	Loc. in Sec.
Anh.				SW NW NW NE
Tp.				twin well
H.				
Tr.				
Dg.				
Bl.				
L.				Geol.
K.C.				Contr.
B.K.C.				Mallard
Ce.				
C.				Pool
M.	2917			Ritz-Canton
M.				
K.				
Mz.				
Mo.				
V.				
S.				
S.				
A.				
R.				
PE.				
G.				
T.D.	2993			

ABANDONED

Date Comm. 5-19-56 JUN 20 1956
 8" @ 157/90 drlg. 1010 MAY 29 '56 5 1/2

@ 2990/75 JUN 6 '56 JUN 13 '56 JUN 20 '56

CO 2993 DD 3008 TD 8 5

Bwph PB 2983 65/2944-76

8 Bwph + 550

DEA

County McPherson Elev. _____
 Sec. 28 Twp. 19 Rgs. 1W
 Company Geo. Hess & Louis Kahn
 Farm Name Bahar No. 1

TOPS	DEPTH	LOG	DATUM	Loc. in Sec.
Anh.				SW NW NW NE
Tp.				twin well
H.				
Tr.				
Dg.				
Bl.				
L.				Geol. _____
K.C.				Contr. _____
B.K.C.				Mallard
Ce.				Pool _____
C.				Ritz-Canton
M.				
M.				
K.				
Mz.				
Mo.				
V.				
S.				
S.				
A.				
R.				
Pc.				FIRST REPORT
G.				MAY 23 '56
T.D.				

Date Comm. 5-19-56
8" @ 157/90 drlg. 1010

3281 P S YAM

2.5

2.5