


Section 23 Township 23 Range 13 EWell No. 3 BahrCompany Barnett & Hart

NORTH

WEST

EAST

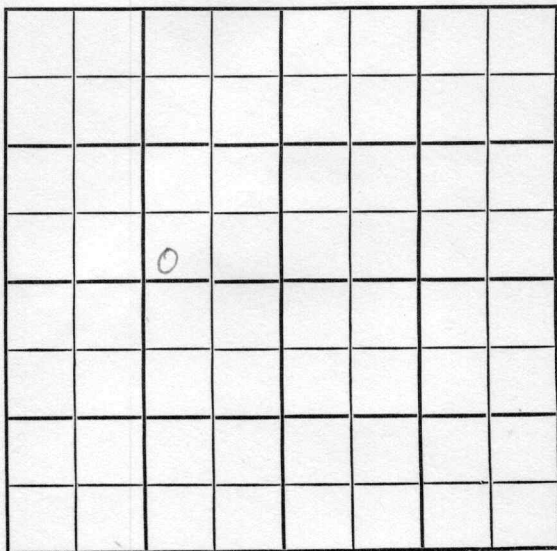

SOUTH

Woodson

KANSAS

SEC. 23	TWP. 23 13E	R. 13E
---------	-------------	--------

WELL NO.

#3 Bahr

FARM

COMPANY

Barnett & Hart

CONTRACTOR

Winter schield


_____ Ft. from N. Line

_____ Ft. from S. Line

_____ Ft. from E. Line

_____ Ft. from W. Line

SW SE NW

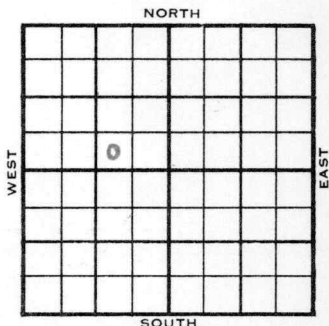

1955

ELEVATION

1208'

REPORT

7/20

Comm 6-21-55

TD 2135 5" @2134 DST 1770-1800

open 80 min. Rec. 30' mw 340# DST

2126-35 open 1 hr. Rec. 40' oil

20' wtr. 700# CO 23/2126-30 frac

Tops	Depth	Log
------	-------	-----

Ce Bart	1640	1638
---------	------	------

CBBart	1680	1684
--------	------	------

M. Lm	1738	1733
-------	------	------

K.	2013	2013
----	------	------

S.	2125	2123
----	------	------

A.	2133	
----	------	--

TD 2135	2134	
---------	------	--

7/27

Comm 6-21-55

BKC Bart 1640 1638

Ce. B. Bart 1680 1684

M Lm 1738 1733

K 2013 2013

S 2125 2123

A 2133

TD ~~2112~~ 2135 2134

TD 2135, 5" @ 2134 DST 1770-1800

open 80 min. Rec 30' mw 340# DST 2126-

35 open 1 hr Rec 40' oil 20' wtr 700#

CO 23/2126-30 frac S/100 bo Comp 25

bopd

COMPLETED

County Woodson Elev. 1208
 Sec. 23 Twp. 23 Rge. 13E
 Company Barnett & Hart
 Farm Name Bahr No. 3

TOPS	DEPTH	LOG	DATUM
Anh.			
Tr.			
H.			
Tr.			
Dg.			
BL.			
L.			
K.C.			
B.K.C.			
Ce. <u>B. Bank</u>	<u>1640</u>	<u>1638</u>	
C. <u>B. Bank</u>	<u>1680</u>	<u>1684</u>	
M.			
M. <u>Lm</u>	<u>1738</u>	<u>1733</u>	
K.	<u>2013</u>	<u>2013</u>	
Mz.			
Mq.			
V.			
S.	<u>2125</u>	<u>2123</u>	
S.			
A.	<u>2133</u>		
R.			
Pe.			
G.			
T.D.	<u>2135</u>	<u>2134</u>	

Loc. in Sec. _____

SW SE NW3

Geol. _____

Contr. _____

Pool _____

WinterschiedJUL 20 '550**FIRST REPORT**Date Comm. 6-21-55TD 2135 5" @ 2134 DST 1770-1800open 80 min. Rec. 30' mw 340#DST 2126-35 open 1 hr. Rec. 40' oil20' wtr. 700# CO 23/ 2126-30 fracVIRGIL FLD.

County Woodson Elev. 1208
Sec. 23 Twp. 23 Rge. 13E
Company Barnett & Hart
Farm Name Bahr No. 3

TOPS	DEPTH	LOG	DATUM	Loc. in Sec.
Anh.				SW SE NW
TP.				
H.				
Tr.				
Dg.				
BL.				Geol.
L.				
K.C.				
B.K.C. <u>Bahr</u>	<u>1640</u>	<u>1638</u>	<u>430</u>	
C. <u>B. Bahr</u>	<u>1680</u>	<u>1684</u>	<u>476</u>	
C.				Contr.
M. <u>Lm</u>	<u>1738</u>	<u>1733</u>	<u>525</u>	
M.				
K.	<u>2013</u>	<u>2013</u>	<u>805</u>	
Mz.				
Me.				Pool
V.				
S.	<u>2125</u>	<u>2123</u>	<u>715</u>	
S.				
A.	<u>2133</u>		<u>925</u>	
R.				Winterscheid
Pe.				
G.	<u>6"</u>		<u>926</u>	
	<u>PR</u>		<u>916</u>	
TD.	<u>2135</u>	<u>2134</u>	<u>926</u>	

Date Comm. 6-21-55 JUL 27 1955

TD 2135 5" @ 2134 DST 1770-1800
open 80 min. Rec. 30' mw 340#
DST 2126-35 open 1 hr. Rec. 40' oil
20' wtr. 700# CO 23/ 2126-30
frac S/ 100 bo Comp. 25 bopd

Vigil