


KANSAS

Rice

Section 21 Township 18 Range 10WWell No. 3 AppelCompany Anderson-Prichard

Orth Pool

NORTH

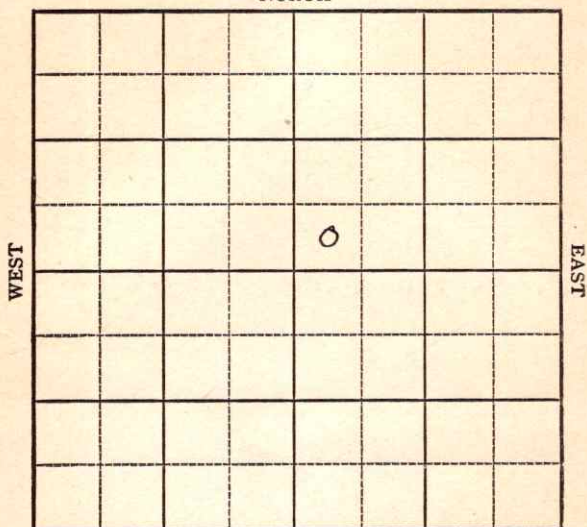

SOUTH

KANSAS

Rice

Sec. 21 Twp. 18 R. 10W ✓

Well No. #3 Appel Farm

Anderson-Prichard Company

Orth Pool


 Ft. from N. Line

330' Ft. from S. Line

 Ft. from E. Line

330' Ft. from W. Line

SW NE

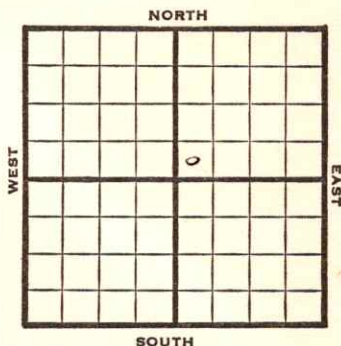

1948

Elev. 1743' REPORT

8/18

RUR

8/25

8" @ 253'

Drlg 2699'

9/1

Topeka 2488'

Lansing 2883'

Arbuckle 3225'

TD 3229'

"

9/8

9/14

TD 3240'

9/21

"

9/29

Pump 154 bbls oil 18 hrs.

10/6

Arbuckle 3225'

5" @ 3229'

5000 acid

Pump 209 oil Pot.

Gr. 42°

TD 3240'

COMPLETED

Rice County Kansas State 10W
 Map No. _____ Sec. 21 Twp. 18 R. _____

Well No. 3 Appel

Anderson-Prichard Company

FIRST REPORT Contractor

SW NE

SECTION PLAT

_____ Ft. from N. Line

330 Ft. from S. Line

_____ Ft. from E. Line

330 Ft. from W. Line

Orth Pool
 Remarks:

R U R

Date AUG 1 8 1948 Scout S. J. LEWIS

Map No. 5 Sec. 21 Twp. 18 R. 10WWell No. 3 AppelAnderson-Prichard CompanyCOMPLETE Contractor

SW NE

E1, 1743

SECTION PLAT

 Ft. from N. Line330 Ft. from S. Line Ft. from E. Line330 Ft. from W. LineRice CountyLocation Rig up

Drilling and Remarks:

CR 32255' @ 32255000 ac. oilProd 209 oil2542 2/22

RECORD

Cased in., ft.Sand Gas Oil Total Depth 8240

PRODUCTION

1st 24 hrs. Nat. 1st 24 hrs. after shot Gas Cu. Ft.Dry Hole Abandoned

Date

OCT 6 1948S. J. LEWIS

Scout