
FORM 51 10M 7-48 PETROL

KANSAS Rice

Section 21 Township 18 Range 10W

Well No. 3 Bieberle

Company Murfin et al

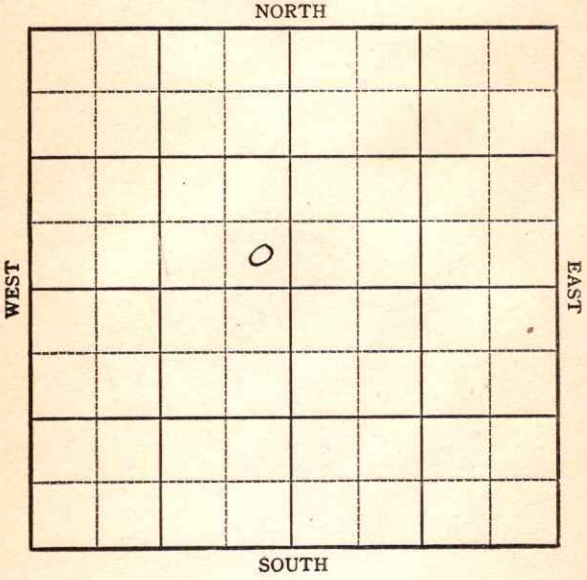

FORM 252-A
5M 4-48 PETROL

KANSAS Rice ✓

Sec. 21 Twp. 18 R. 10-W

Well No. #3 Bieberle Farm

Murfin etal Company

Orth


____ Ft. from N. Line

330 Ft. from S. Line

330 Ft. from E. Line

____ Ft. from W. Line

SE NW

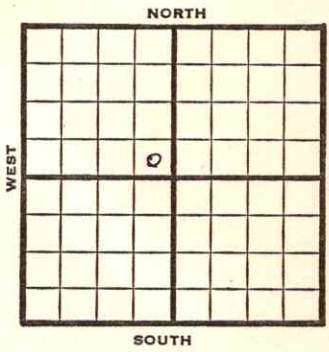

	REPORT
1948	Eli 1742'
8/11	8"@ 226' Anhy 440' Drlg 2590'
8/18	Arb. 3215' 5"@ 3219' TD
8/25	TD 3234 2000' oil 3/4 hrs
9/1	"
9/8	"
9/14	"
9/21	"
9/29	Pump 84 bbls oil 24 hrs.
10/6	"
10/13	"
10/20	TD 3234' Arb. 3215' 5"@ 3219' Pump 388 Pot 41° Gr. Comp COMPLETED

Form 27—100 Bks.—4-48—Petrol

Rice County Kansas State

Map No. Sec. 21 Twp. 18 R. 10W


Well No. 3 Bieberle

Murfin etal. Company

FIRST REPORT Contractor

SE NW

SECTION PLAT

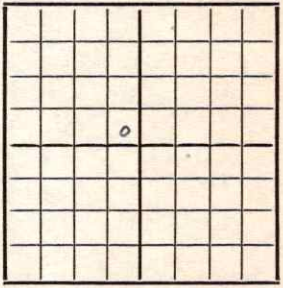

Ft. from N. Line

330 Ft. from S. Line

330 Ft. from E. Line

Ft. from W. Line

Orth Pool

Remarks:

8" @ 226 Anhy 440 drlg. 2590

Date AUG 11 1948 Scout S. J. LEWIS

Form 26 200 Bks. 9-48 Petrol

Kansas

Orth Pool

Map No. 55 Sec. 21 Twp. 18 R. 10W

Well No. 3 Bieberle


Murfin etal. Company

COMPLETE Contractor

SE NW

E 1742

SECTION PLAT

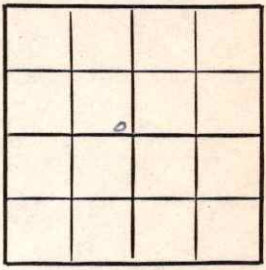

330 Ft. from N. Line

330 Ft. from S. Line

330 Ft. from E. Line

Ft. from W. Line

Rice County

Location

Rig up

Drilling and Remarks:

Cr 3215

5" 3219

Prod 3255 PBTD

RECORD

Cased in., ft.

Sand

Gas

Oil ✓

Total Depth 3234

PRODUCTION

1st 24 hrs. Nat.

1st 24 hrs. after shot

Gas Cu. Ft.

Dry Hole

Abandoned

Date

OCT 20 1948 19

S. J. LEWIS Scout