

KANSAS

Rice

Section 21 Township 18 Range 10WWell No. 4 FeistCompany Anderson-Prichard

Chase Pool

NORTH

WEST

EAST

SOUTH

0

KANSAS Rice

Sec. 21 Twp. 18 R. 10-W

Well No. #4 Feist Farm

Anderson-Prichard Company
Chase Pool

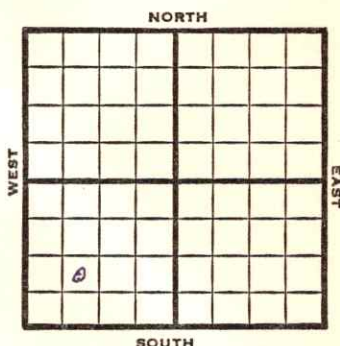
 Ft. from N. Line

990 Ft. from S. Line

 Ft. from E. Line

990 Ft. from W. Line

NE SW SW



1948

Eli 1742'

R E P O R T

11/3

8" @ 277'

11/10

Drlg. 2750'

11/16

Lansing 2884'

Quartzite 3170'

TD 3176'

5" @ 3171'

11/23

"

11/30

"

12/8

TD 3254'

42 shots 2688-2702- 500 acid

Swb 27 oil SW 8 hrs.

12/15

"

12/22

"

12/29

"

1/5

"

1/12

"

1/19

TD 3254'

Topeka 2484'

Quartzite 3170'

5" @ 3171'

Perf top

500 acid

Pump 16 oil / 11 W Pot

41° Gr.

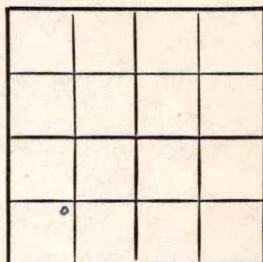
Comp

COMPLETED

Map No. _____ Sec. 21 Twp. 18 R. 10WWell No. 4 FeistAnderson-Prichard CompanyFIRST REPORT Contractor

NE SW SW

SECTION PLAT

_____
Ft. from N. Line990
Ft. from S. Line_____
Ft. from E. Line990
Ft. from W. LineRice County

RECORD

Location _____

Cased _____ in., _____ ft.

Rig up _____

Sand _____

Drilling and Remarks:

Gas _____

Oil _____

Total Depth _____

8" @ 277

PRODUCTION

1st 24 hrs. Nat. _____

1st 24 hrs. after shot _____

Gas _____ Cu. Ft.

Dry Hole _____

Abandoned _____

Date

NOV 3 1948 19S. J. LEWIS

Scout

Kansas

Orth Pool

Map No. 55 Sec. 21 Twp. 18 R. 10WWell No. 4 Feist

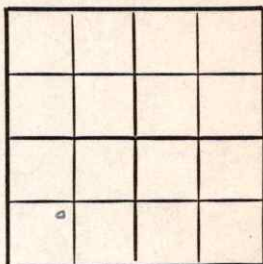
Anderson-Prichard

Company

COMPLETE

Contractor

NE SW SW

E. 11742
SECTION PLAT

Ft. from N. Line

990

Ft. from S. Line

Ft. from E. Line

990

Ft. from W. Line

Rice County

RECORD

Location

Cased _____ in., _____ ft.

Rig up

Sand _____

Drilling and Remarks:

Gas _____

Oil ☒Total Depth 3454

PRODUCTION

1st 24 hrs. Nat. _____

1st 24 hrs. after shot _____

Gas _____ Cu. Ft.

Dry Hole _____

Abandoned _____

Date

JAN 19 1949

19

S. J. LEWIS

Scout