
McPherson

Form 51—5M—2-29—34703

Map No. KANSAS Sec. 21 Twp. 19 R. 1 W

Well No. 1 Laura Shaw Farm

Muller Nat Company

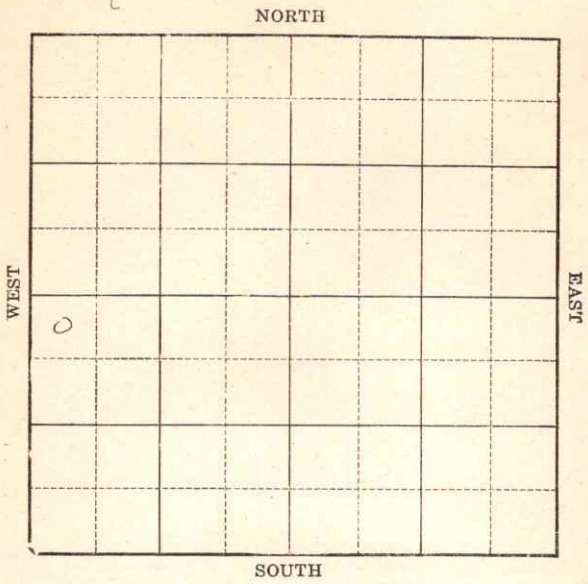

Location

Drilling Remarks

Rig Up

Drilling Remarks

RECORD

Cased in. ft.

Sand

Gas

Oil

Total Depth

PRODUCTION

1st 24 hrs. Nat.

1st 24 hrs. after shot

Gas cu. ft.

Dry Hole

Abandoned

McPherson

FORM 252A-5M-8-30-PETROL

Map No. KANSAS Sec. 21 Twp. 19 R. 1W

Well No. 1 Laura Shaw Farm


Miller etal Company

330 Ft. from N. Line

Ft. from S. Line

Ft. from E. Line

330 Ft. from W. Line

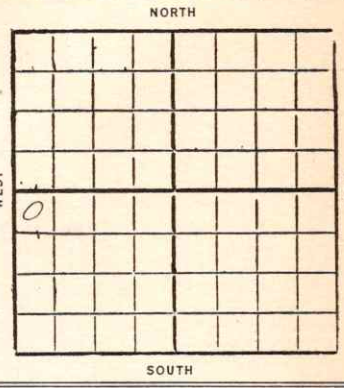

1931

Date	REPORT
	Loc
6/3	Rig up
6/10	Spdg 160'
6/17	" 15"-440
6/24	drlg 855
	" 1662
7/1	" 1950'
7/8	10"-2287
7/15	10 Lbe sho 2350-60
7/22	Drlg 2815
	Chat 2913-14'
7/29	show gas
	8"-2913
	Pulling big pipe
	10 M gas at 2941
8/5	Inc to 18M at 2955
	Chat 2913-53
8/12	T.D. 2953
	51,278,000 cu ft gas
	Comp!

Form 26—1M Bks. 9-28

KANSAS

McPherson

Map No. 43 Sec. 21 Twp. 19 R. 1 W

Well No. 1 Laura Shaw

Miller et al Company

Contractor

FIRST REPORTS


330 Ft. from N. Line

Ft. from S. Line

Ft. from E. Line

330 Ft. from W. Line

SECTION PLAT

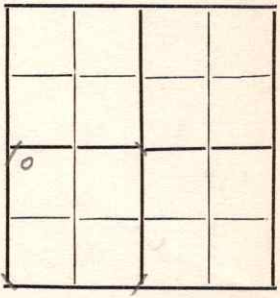

Location ✓

Rig up

Drilling and Remarks:

RECORD

Cased in., ft.

Sand

Gas

Oil

Total Depth

PRODUCTION

1st 24 hrs. Nat.

1st 24 hrs. after shot

Gas Cu. Ft.

Dry Hole

Abandoned

Date

JUN 3 1931

192

CHAS. L. SHERWOOD Scout

Form 26—1M Bks.—9-28

McPherson

KANSAS

Map No. ..... Sec. 21 Twp. 19 R. 1 W

43

Well No. 1 Laura Shaw

Miller et al ..... Company

..... Contractor

COMPLETE


330 Ft. from N. Line

..... Ft. from S. Line

..... Ft. from E. Line

330 Ft. from W. Line

SECTION PLAT

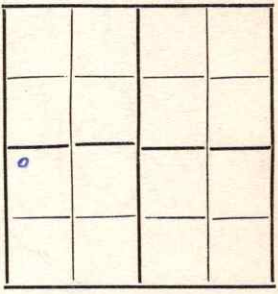

Location .....

Rig up .....

Drilling and Remarks:

RECORD

Cased ..... in., ... ft.

Sand Chat 2913-53

Gas .....

Oil .....

Total Depth 2953

PRODUCTION

1st 24 hrs. Nat. .....

1st 24 hrs. after shot .....

Gas 51,276,000 Cu. Ft.

Dry Hole .....

Abandoned .....

Date

AUG 12 1931 192.....

CHAS. L. SHERWOOD

..... Scout