


Section 15 Township 18 Range 10-W

Well No. #1 Schultz

Company Bay Petroleum
Heinz Pool

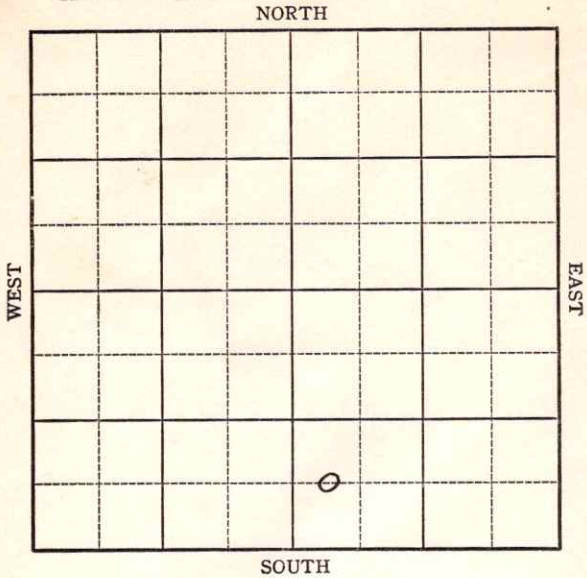

Sec. 15 Twp. 18 R. 10-W

Well No. #1 Schultz Farm

Bay Petroleum Company


(Heinz Pool)

_____ Ft. from N. Line

660 Ft. from S. Line

_____ Ft. from E. Line

330 Ft. from W. Line

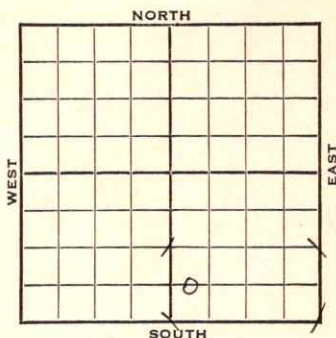

REPORT

1942

8/27

Rotary

9/2

8" - 273

Anhy 444

Drlg. 1605'

9/9

Lans 2918

Drlg 3113

9/16

Cong. 3235

No shows

TD 3280

ABANDONED

Rice

KANSAS

Map No. 55 Sec. 15 Twp. 18 R. 10WWell No. 1 SchultzBay Petroleum

Company

FIRST REPORT

Contractor

C WL SW SE

SECTION PLAT

 Ft. from N. Line660 Ft. from S. Line Ft. from E. Line330 Ft. from W. Line

HEINZ POOL

Location Rig up

Drilling and Remarks:

Rotary

RECORD

Cased in., ft.Sand Gas Oil Total Depth

PRODUCTION

1st 24 hrs. Nat. 1st 24 hrs. after shot Gas Cu. Ft.Dry Hole Abandoned

Date

AUG 27 1942 19S. J. LEWIS

Scout

Map No. 55 Sec. 15 Twp. 18 R. 10WWell No. 1 SchultzBay Petroleum CompanyABANDONED Contractor

C WL SW SE

SECTION PLAT

 Ft. from N. Line660 Ft. from S. Line Ft. from E. Line330 Ft. from W. Line

		o	

HEINZ POOL

Location Rig up

Drilling and Remarks:

Comp 3235Noshore

RECORD

Cased in., ft.Sand Gas Oil Total Depth 3280

PRODUCTION

1st 24 hrs. Nat. 1st 24 hrs. after shot Gas Cu. Ft.Dry Hole Abandoned

Date

SEP 16 1942 19S. J. LEWIS Scout