


Section 16 Township 18 Range 10W

Well No. 2 Schmidt

Company Anderson-Prichard
Chase Pool

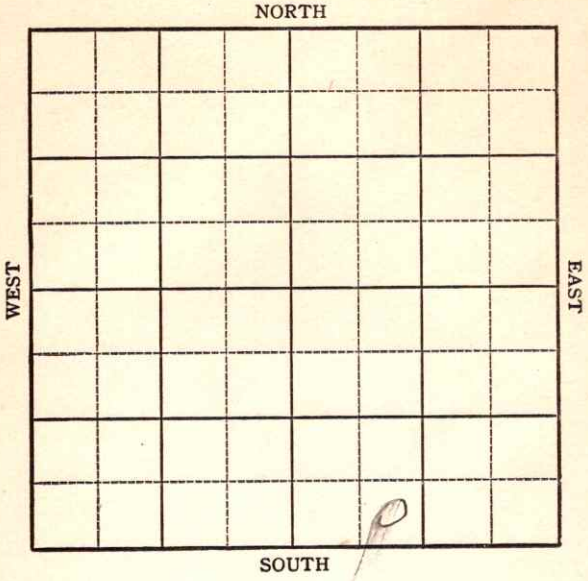

KANSAS

Rice ✓


Sec. 16 Twp. 18 R. 10W

Well No. 2 Schmidt Farm

Anderson-Pritchard Company

Chase Pool

NORTH

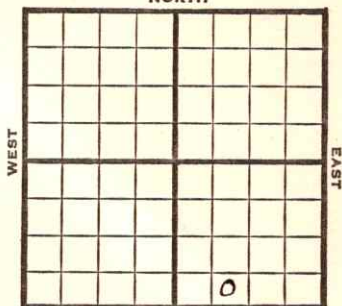

_____ Ft. from N. Line

330 Ft. from S. Line

_____ Ft. from E. Line

990 Ft. from W. Line

SE SW SE

SOUTH

1948 **Elev. 1759'** REPORT

9/1 Location

9/8 8" @ 249'
Drlg 2529'

9/14 **Arb. 3252-56'**
TD 3256'
5" @ 3254'

9/21 1000 acid

9/29 Swb 10 1/2 bbls oil 13 hrs.

10/6 **Arbuckle 3252'**
5" @ 3254'
1000 acid
Pump 152 oil Pot.
Gr. 42°
TD 3278'

COMPLETED

Kansas

Map No. 55 Sec. 16 Twp. 18 R. 10WWell No. 2 SchmidtAnderson-Prichard CompanyCOMPLETE Contractor

SE SW SE

E. 1759
SECTION PLAT

| | | | |
|--|--|--|--|
| | | | |
| | | | |
| | | | |
| | | | |
| | | | |

 Ft. from N. Line330 Ft. from S. Line Ft. from E. Line990 Ft. from W. Line

Rice County

Location Rig up

Drilling and Remarks:


RECORD

Cased in., ft.Sand Gas Oil Total Depth 3270

PRODUCTION

1st 24 hrs. Nat. 1st 24 hrs. after shot Gas Cu. Ft.Dry Hole Abandoned

Date

OCT 6 1948 19 S. J. LEWIS Scout