
Woodson KANSAS

SECTION 23 TOWNSHIP 23 RANGE 13 E

WELL NO. #4 Bahr

COMPANY Barnett & Hart

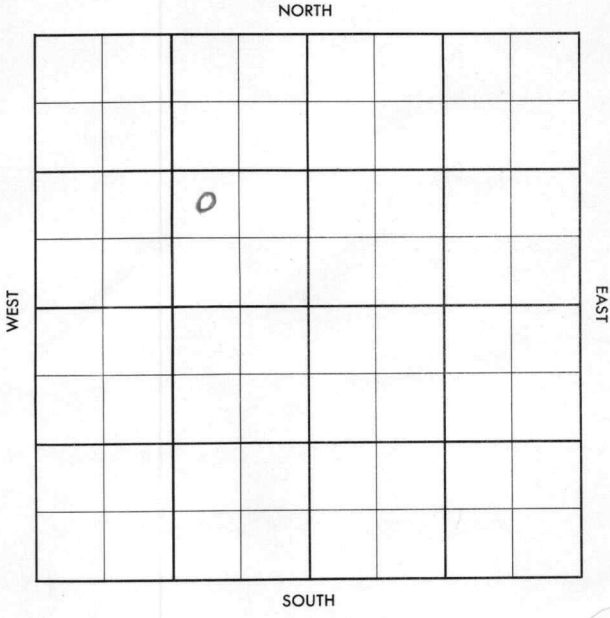

FORM 504-3 SUNRAY

Woodson KANSAS

SEC.	TWP.	R.
23	23	13E

WELL NO.

#4 Bahr FARM

COMPANY

Barnett & Hart

CONTRACTOR

White & Ellis

N. ### Virgil


_____ Ft. from N. Line

_____ Ft. from S. Line

_____ Ft. from E. Line

_____ Ft. from W. Line

NW SE NW

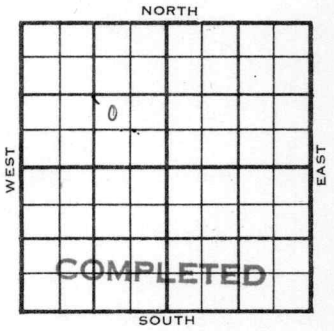

1956	ELEVATION REPORT
2-1	Comm. 1-28-56 8" @ 102 Drlg. 1700

DX-78

FORM 513 REV. SUNRAY

County Woodson Elev.

Sec. 23 Twp. 23 Rge. 13E

Company Barnett & Hart

Farm Name Bahr No. 4

TOPS	DEPTH	LOG	DATUM
Anh.			
Tp.			
H.			
Tr.			
Dg.			
B.L.			
L.			
K.C.			
B.K.C.			
Ce.			
C.			
M.			
M.			
K.			
Mz.			
Mo.			
V.			
S.			
S.			
A			
R.			
P€.			
G.			
T.D.			

Loc. in Sec. NW SE NW

Geol.

Contr. White & Ellis

Pool N. Virgil

FIRST REPORT

FEB 1 '56

Date Comm. 1-28-56

8" @ 102 drlg. 1700

Co. Lse. No. Sec. T. R.

FORM 513 REV SUNRAY

County Woodson Elev. 1227 KB

Sec. 23 Twp. 23 Rge. 13E

Company Barnett & Hart

Farm Name Bahr No. 4

TOPS	DEPTH	LOG	DATUM
Anh.			
Tp.			
H.			
Tr.			
Dg. Barth.	1637		410
Bl.			
L.			
K.C.			
B.K.C.			
Ce.			
C.			
M.	1742		515
M. Base	2038		811
K.			
Mz.	2152		925
Mo.			
V.			
S. Dolo	2153		926
S. sd	2164		937
A	2174		947
R.			
Pf.			
G.			
T.D.	2178		

Loc. in Sec. NW SE NW

Geol.

Contr. White & Ellis

Pool N. Virgil

COMPLETE

Date Comm. 1-28-56 MAR 7 1956

8" @ 102 drlg. 1700 FEB 8 '56

~~2177~~ FEB 15 '56 ✓ FEB 22 '56 5½ 2177

co 2178 FO 1095' oil + wtr

in 10 hrs FEB 29 '56 P&P

MAR 7 '56 P. 15 Bopd + 30 Bwpd