FORM 51 25M 3-49 PETROL


Rice

KANSAS

Section 17 Township 18 Range 10W

Well No. #1 Heinz "A"

Company Skelly Oil

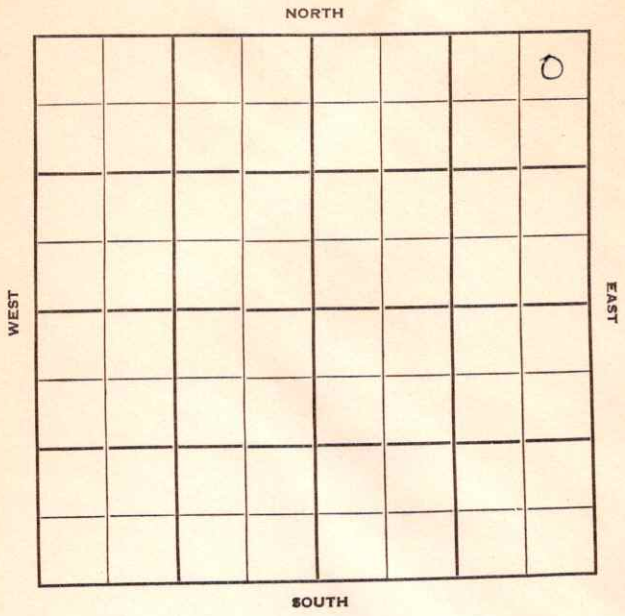

FORM 252-B
10M 9-49 PETROL

Rice KANSAS

Sec. 17 Twp. 18 R. 10W

Well No. #1 Heinz "A" Farm

Skelly Oil Company

Contractor

Heinz Pool


330' Ft. from N. Line

Ft. from S. Line

330' Ft. from E. Line

Ft. from W. Line

NE NE NE

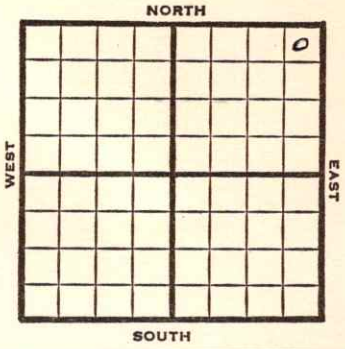

1950	Elev 1756' REPORT
3/29	RUR
5/3	TD 3302' 8" @ 525' Lans 2927' Cong 3248' Arb. 3302' 5"@ 3140' D&A Aband. ABANDONED

Form 26 200 Bks. 11-49 Petrol

Kansas

Heinz Pool

Map No. _____ Sec. 17 Twp. 18 R. 10W


Well No. 1 Heinz "A"

Skelly Oil Company

Contractor

NE NE NE

SECTION PLAT

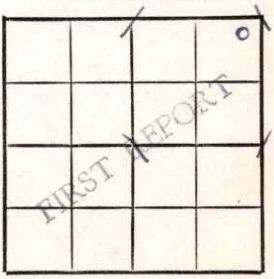

330 Ft. from N. Line

Ft. from S. Line

330 Ft. from E. Line

Ft. from W. Line

Rice County

Location

Rig up

Drilling and Remarks:

R U R

RECORD

Cased _____ in., _____ ft.

Sand

Gas

Oil

Total Depth

PRODUCTION

1st 24 hrs. Nat.

1st 24 hrs. after shot

Gas _____ Cu. Ft.

Dry Hole

Abandoned

Date

MAR 2 9 1950 19 J. E. TYRA Scout

Form 26 200 Bks. 11-49 Petrol

Heinz Pool

Kansas

Map No. ____ Sec. 17 Twp. 18 R. 10W

Well No. 1 Heinz "A"

Skelly Oil Company

Contractor

NE NE NE

El. 1756

SECTION PLAT



330 Ft. from N. Line

Ft. from S. Line

330 Ft. from E. Line

Ft. from W. Line

Rice County

Location

Rig up

Drilling and Remarks:

8" @ 525
Lans 2927
Cong 3248
Arb 3302
5" @ 3140
D & A

RECORD

Cased ____ in., ____ ft.

Sand

Gas

Oil

Total Depth 3302

PRODUCTION

1st 24 hrs. Nat.

1st 24 hrs. after shot

Gas ____ Cu. Ft.

Dry Hole

Abandoned

Date

MAY 3 1950 19

J. E. TYRA Scout