

KANSAS

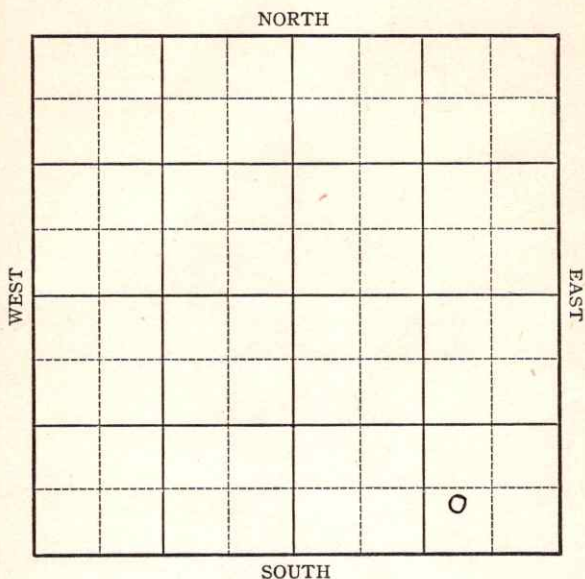
Rice

FORM 51 5M 1-42 PETROL

Section 16 Township 18 Range 10-W

Well No. #1 Schmidt

Company Bartlett & Crum

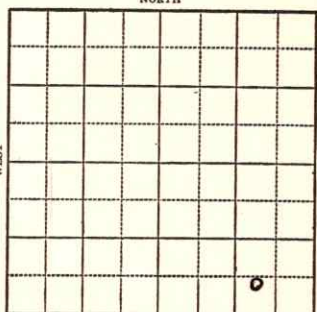


KANSAS

Rice

Sec. 16 Twp. 18 R. 10-WWell No. #1 Schmidt FarmBartlett & Crum Company

NORTH

 Ft. from N. Line560 Ft. from S. Line960 Ft. from E. Line Ft. from W. LineElev. 1755

SOUTH

1943

R E P O R T

5/19	Drlg. 1875'
5/26	Never was ever squadded
6/2	Loc.
6/9	"
6/16	Cable rig
6/23	" "
6/30	" "
7/7	" "
7/15	15" @ 60'
	12" @ 460'
	Drlg. 470'
7/21	Drlg. 1550'
7/28	10" @ 1790'
	Drlg. 1795'
8/4	Topeka 2510'
	Drlg. 2661'
8/11	Lans 2940'
	Drlg. 3160'
8/18	Arb 3260'
	T.D. 3283 SO
	Run 5"

OVER

1943

8/25 5" @ 3270-1750 oil 2 hrs.

9/1 " " " "

9/8 " " " "

9/15 Arb 3260

5" @ 3270

Pump 215 Pot.

T.D. 3283

Gravity 41.4

COMPLETED

KANSAS

Rice

Map No. 55 Sec. 16 Twp. 18 R. 10WWell No. 1 SchmidtBartlett & Crum

Company

FIRST REPORT

Contractor

C WL SE SE

SECTION PLAT

			0

 Ft. from N. Line560 Ft. from S. Line960 Ft. from E. Line Ft. from W. LineORTH POOLLocation Rig up

Drilling and Remarks:

Drlg. 1875'

RECORD

Cased in., ft.Sand Gas Oil Total Depth

PRODUCTION

1st 24 hrs. Nat. 1st 24 hrs. after shot Gas Cu. Ft.Dry Hole Abandoned

Date

MAY 19 1943 19

S. J. LEWIS

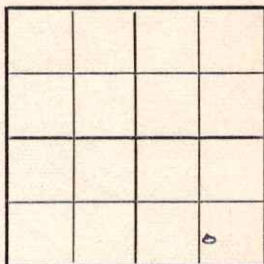
Scout

KANSAS

Map No. 55 Sec. 16 Twp. 18 R. 10WWell No. 1 SchmidtBartlett & Crum CompanyCOMPLETED Contractor

C W L SE SE

SECTION PLAT

 Ft. from N. Line560 Ft. from S. Line960 Ft. from E. Line Ft. from W. Line

Orth Pool

Location Rig up

Drilling and Remarks:

*Ar 43260**Ar 103270**Pump 25 Rd**41 1/2*

RECORD

Cased in., ft.Sand Gas Oil Total Depth 3283

PRODUCTION

1st 24 hrs. Nat. 1st 24 hrs. after shot Gas Cu. Ft.Dry Hole Abandoned

Date

SEP 15 1943

19

S. J. LEWIS

Scout