
FORM 51 25M 8-50 WESTERN Rice KANSAS

Section 16 Township 18 Range 10 W

Well No. # 3 Schmidt

Company Anderson-Prichard

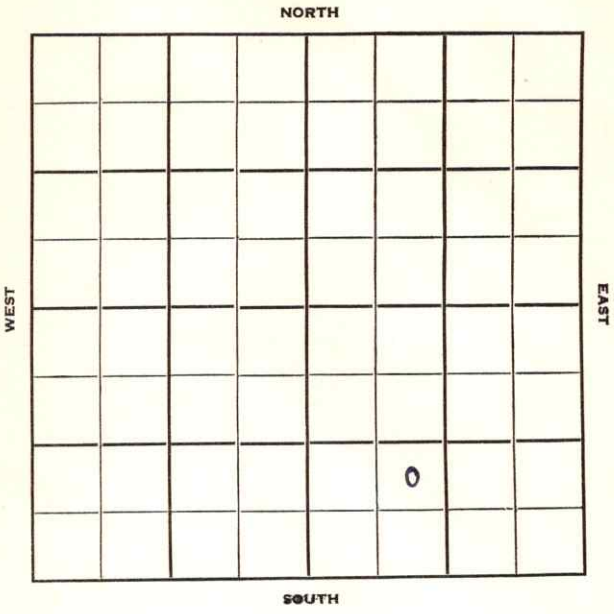

FORM 252-B
10M 10-50 PETROL

Rice

KANSAS

Sec. 16 Twp. 18 R. 10W

Well No. #3 Schmidt Farm

Anderson-Prichard Company

Peel Bros. Contractor


____ Ft. from N. Line

990 Ft. from S. Line

____ Ft. from E. Line

990 Ft. from W. Line

NE SW SE

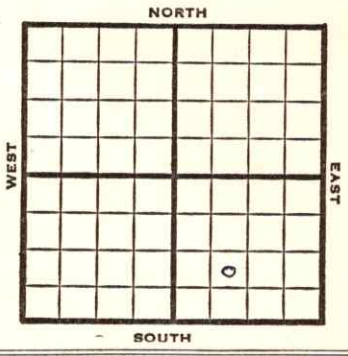

1952	Elev. 1757' REPORT
3/19	Spud 3-13-52 8" @ 247' Drlg. 2100'
3/25	DST 2731-39', 2 hrs. 140' m & SW 740# Heeb. 2782 Br Li 2898 Lans. 2917 DST 3000-3007, 75 mins. 230' GCSW 1300' gas 800# Drlg. 3748'
4/1	Chert cong. 3231 Arb. 3260 DST 3262-67, 1 hr. 65' OCM 870# RTD 3267 5" @ 3261 CO to 3267 20 goph 250A S/ 6 boph POP
4/8	"
4/23	DD 3270 S/3½ BF 13 hrs. 1½% wtr DD 3273 P/15 BO & 15% wtr 24 hrs. P/18 BO 15% wtr 44 hrs.
4/30	"
5/7	"
5/14	NR

OVER

1952
5/21 Spud 3-13-52
Oil Well. TD 3273' 8" @ 247'
DST 2731-39 open 2 hr. rec 140' mud
& SW. Heeb 2782' Br. lime 2898'
Lans. 2917'
DST 3000-07 open 75 min, rec 230' GCSW
1300' gas.
Cong. 3231' Arb. 3260'
DST 3262-67 open 1 hr. rec 65' OCM
TD 3267' 5" @ 3261 CO to 3267
20 GOPH 250 A S/6 BOPH DD 3270'
S/8½ BF 13 hr. 1½% water DD 3273
P/15 BO 15% water P/18 BO 15% water.
Comp. 11 BOPD 3 BW

COMPLETED

FORM 275 FOR SALE BY KANSAS BLUE PRINT CO.

County Rice State Kansas

Sec. 16 (Blk. Twp.) 18 (Sur. Rge.) 10W Map No.

Operator Anderson-Prichard

Well No. 3 Farm Schmidt

Elev. Location NE SW SE



990 Ft. From S Line SE

990 Ft. From W Line Quarter

1st. Report MAR 19 1952

Completion

Remarks Peel Bros - Contr.

Spudding Date 3-13-52

Drlg. Data

8" @ 247 drlg. 2100

J. G. McGEHEE

FORM 275 FOR SALE BY KANSAS BLUE PRINT CO.

County Rice State Kansas

Sec. 16 (Blk. Twp.) 18 (Sur. Rge.) 10W Map No.

Operator Anderson-Prichard

Well No. 3 Farm Schmidt

Elev. 1757 Location NE SW SE



990 Ft. From S Line SE

990 Ft. From W Line Quarter

1st. Report

Completion MAY 21 1952

Remarks

Peel Bros. - Contr.

Spudding Date 3-13-52

Drlg. Data Oil well TD 3273

8" @ 247 DST 2731-39 open 2 hr.

Rec. 140' mud & sw Heeb. 2782

Br. lime 2898 Lans. 2917 DST 3000-07

open 75 min. Rec. 230' gcsw 1300' gas

Cong. 3231 Arb. 3260 DST 3262-67

open 1 hr. Rec. 65' ocm TD 3267

5" @ 3261 CO to 3267 20 gcph 250 A

S/ 6 boph DD 3270 S/ 8½ bf 13 hr.

1½% water DD 3273 P/ 15 bo 15% water

P/ 18 bo 15% water Comp. 11 bopd 3 bw

J. G. McGEE