
FORM 51 Rice KANSAS

Section 17 Township 18 Range 10W

Well No. #1 Joseph Poppelreiter

Company Tom Allan et al

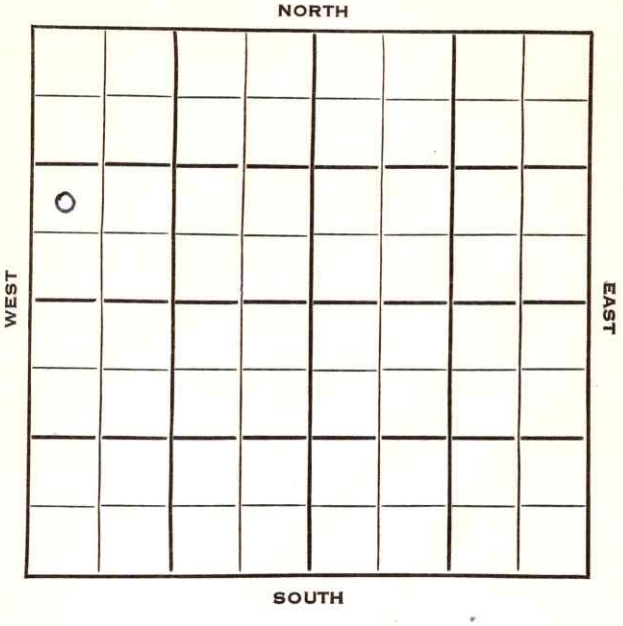

FORM 252-B

Rice KANSAS

Sec. 17 Twp. 18 R. 10 W

Well No. # 1 Joseph Poppelreiter Farm

Tom Allan et al Company

Tom Allen Contractor


____ Ft. from N. Line

990 Ft. from S. Line

____ Ft. from E. Line

330 Ft. from W. Line

NW SW NW

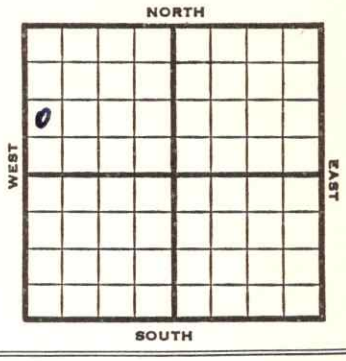

1953	Elev. 1761' REPORT
8/19	Spud 8-16-53 8" @ 221 WOC
8/26	Heeb 2849' Tor 2869' Doug 2875' Br li 2963' Lans 2981' Drlg. 3292'
9/2	Spud 8-16-53 D&A TD 3383 8" @ 211 Heeb 2849, Tor 2869, Doug 2876, Br lime 2963, Lans 2981, Cong 3283, Arb. 3353 TD 3383 D&A

ABANDONED

FORM 275 FOR SALE BY KANSAS BLUE PRINT CO.

County Rice State Kansas

Sec. 17 (Blk. Twp.) 18 (Sur. Rge.) 10W Map No.

Operator Tom Allan etal.

Well No. 1 Farm Joseph Poppelreiter

Elev. Location NW SW NW



990 Ft. From S Line NW

330 Ft. From W Line Quarter

1st. Report AUG 19 1953

Completion

Remarks

Tom Allen - Contr.

Spudding Date 8-16-53

Drlg. Data

8" @ 221 WOC

J. G. McGEHEE

FORM 275 FOR SALE BY KANSAS BLUE PRINT CO.

County Rice State Kansas

Sec. 17 (Blk. Twp.) 18 (Sur. Rge.) 10W Map No.

Operator Tom Allan etal.

Well No. 1 Farm Joseph Poppelreiter

Elev. 1761 Location NW SW NW



990 Ft. From S Line NW

330 Ft. From W Line Quarter

1st. Report

Completion SEP 2 1953

Remarks

Tom Allen - Contr.

Spudding Date 8-16-53

Drlg. Data D & A TD 3383

8" @ 221 Heeb. 2849 Tor. 2869

Doug. 2876 Br. lime 2963 Lans. 2981

Cong. 3283 Arb. 3353 TD 3383

D & A

J. G. McGEHEE