KANSAS

Rice


FORM 51 5M PETROL

Section 17 Township 18 Range 10W

Well No. #1 S. Reiff etal

Company Great Lakes Carbon

Silica Pool

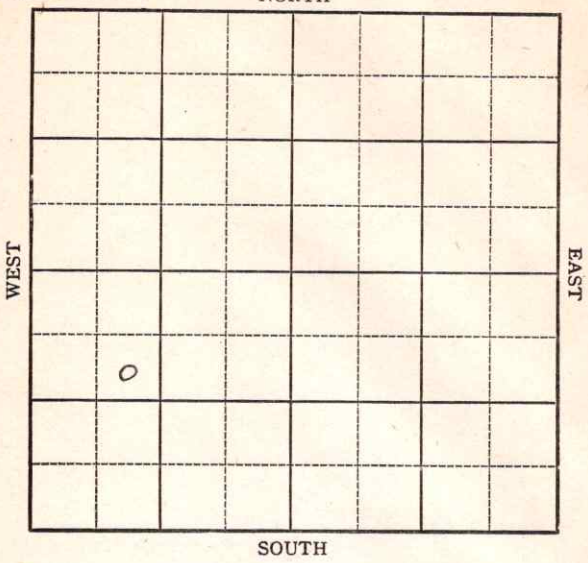

Rice

FORM 252-A
5M 9-43 GASS KANSAS

Sec. 17 Twp. 18 R. 10-W

Well No. #1, S. Reiff etal. Farm


Great Lakes Carbon Company

990 Ft. from N. Line

Ft. from S. Line

Ft. from E. Line

990 Ft. from W. Line

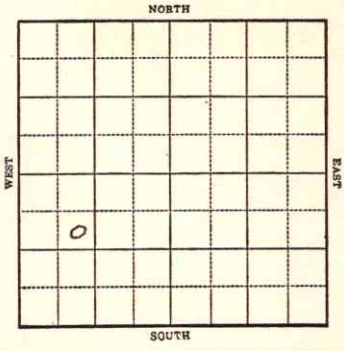

Elev. 1751 REPORT

1943
12/15 Location

12/22 "

12/29 Surface hole

1944
1-5 10" @ 240
Drlg 500'

1-12 Drlg 2420'

1/19 Topeka 2590
Lans 2990
Drlg. 3166'

1/26 Arb 3308
TD 3340

ABANDONED

Form 26 200 Bks 5-42 Petrol

Rice

KANSAS

Map No. ____ Sec. 17 Twp. 18 R. 10W


Well No. 1 S. Reiff etal.

Great Lakes Carbon Company

FIRST REPORT Contractor

SE NW SW

SECTION PLAT

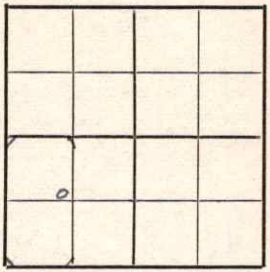

990 Ft. from N. Line

____ Ft. from S. Line

____ Ft. from E. Line

990 Ft. from W. Line

Silica Pool

Location X

Rig up

Drilling and Remarks:

RECORD

Cased ____ in., ____ ft.

Sand

Gas

Oil

Total Depth

PRODUCTION

1st 24 hrs. Nat.

1st 24 hrs. after shot

Gas ____ Cu. Ft.

Dry Hole

Abandoned

Date

DEC 15 1943 19

S. J. LEWIS Scout

Form 26 200 Bks 5-42 Petrol

Rice

KANSAS

Map No. 22 Sec. 17 Twp. 18 R. 10W

Well No. 1 S. Reiff etal.

Great Lakes Carbon Company

ABANDONED Contractor

SE NW SW


990 Ft. from N. Line

Ft. from S. Line

Ft. from E. Line

990 Ft. from W. Line

SECTION PLAT

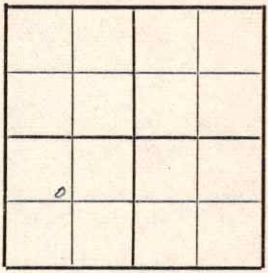

Silica Pool

Location

Rig up

Drilling and Remarks:

Qu 3308

RECORD

Cased in., ft.

Sand

Gas

Oil

Total Depth 3340

PRODUCTION

1st 24 hrs. Nat.

1st 24 hrs. after shot

Gas Cu. Ft.

Dry Hole

Abandoned

Date

JAN 26 1944 19 S. J. LEWIS Scout