

KANSAS

Ellis

FORM 51 25M 3-49 PETROL

Section 1 Township 13 Range 16W

Well No. 1 Schmidt

Company Solar Oil

Fairport
NORTH

WEST

EAST

			0				

SOUTH

11

KANSAS

Ellis ✓

Sec. 1 Twp. 13 R. 16W

Well No. 1 Schmidt Farm

Solar Oil Company

Fairport Pool Ferrell Drlg. NORTH Contr.


330 Ft. from N. Line

_____ Ft. from S. Line

330 Ft. from E. Line

_____ Ft. from W. Line

NE SW

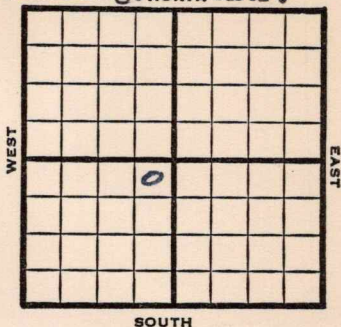

1949 **Elev 1906'** REPORT

9/28 Loc.

10/5 8" @ 983'

Drlg 1980'

10/12 **Lansing 3044'**

Cong 3307'

Drlg 3315'

10/19 **Arb. 3309'**

TD 3315'

5" @ 3312'

10/26 Swb 2 bbls oil PH

11/2 TD 3320'

Arb. 3314'

5" @ 3317'

Pump 25 Oil Pot

37° Gr.

Comp

COMPLETED

Map No. _____ Sec. 1 Twp. 13 R. 16W

Well No. 1 Schmidt

Solar Oil Company

Ferrell Drlg. Contractor

NE SW


FIRST SECTION REPORT PLAT

330 Ft. from N. Line

_____ Ft. from S. Line

330 Ft. from E. Line

_____ Ft. from W. Line

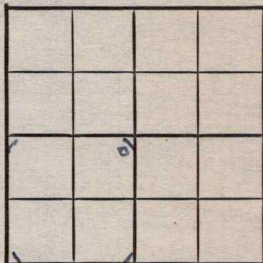

Ellis County

RECORD

Location X

Rig up _____

Drilling and Remarks:

Cased _____ in., _____ ft.

Sand _____

Gas _____

Oil _____

Total Depth _____

PRODUCTION

1st 24 hrs. Nat. _____

1st 24 hrs. after shot _____

Gas _____ Cu. Ft.

Dry Hole _____

Abandoned _____

Date

SEP 28 1949 19

S. J. LEWIS Scout

Kansas

Map No. _____ Sec. 1 Twp. 13 R. 16W

Well No. 1 Schmidt

Solar Oil Company

COMPLETE Contractor

NE SW

E.L. 1906
SECTION PLAT

	o		

330 Ft. from N. Line

_____ Ft. from S. Line

330 Ft. from E. Line

_____ Ft. from W. Line

Ellis County

Location _____

Rig up _____

Drilling and Remarks:

CR 43314

5" C 3317

Pump 25 oil Pot

37° E

RECORD

Cased _____ in., _____ ft.

Sand _____

Gas _____

Oil _____

Total Depth 3320

PRODUCTION

1st 24 hrs. Nat. _____

1st 24 hrs. after shot _____

Gas _____ Cu. Ft.

Dry Hole _____

Abandoned _____

Date

NOV 2 1949 19

S. J. LEWIS Scout