
FORM 51 25M 3-49 PETROL Rice

KANSAS

Section 20 Township 18 Range 10W

Well No. #1 Schultz

Company Heathman & Co.

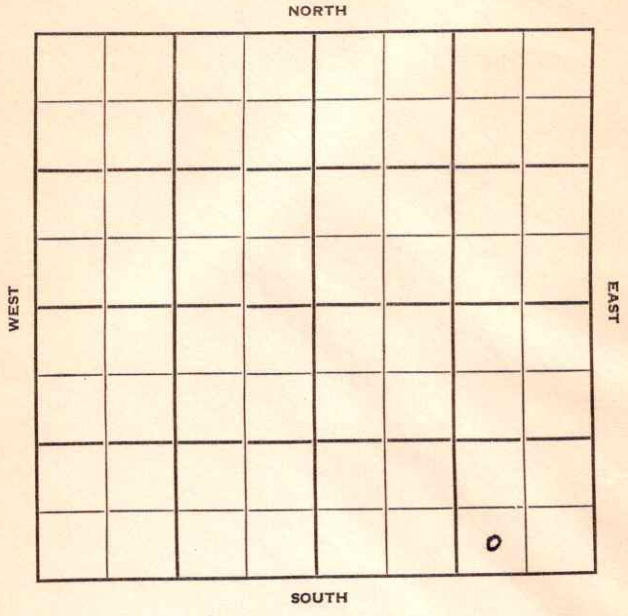

FORM 252-B
10M 8-51 TPCO.

Rice KANSAS

Sec. 20 Twp. 18 R. 10 W

Well No. # 1 Schultz Farm

Heathman & Co. Company

Heathman Contractor
Orth Pool

Ft. from N. Line


330 Ft. from S. Line

990 Ft. from E. Line

Ft. from W. Line

SW SE SE

A-P Farmout

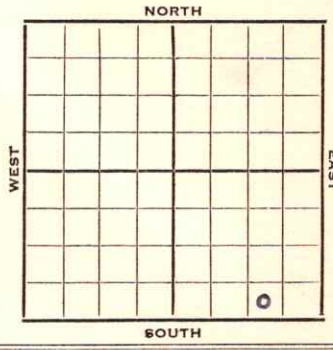

1952 Elev. 1749' REPORT

10/15 Spud 10-13-52
8" @ 310 Anhy 486'
Drlg. 675'

10/22 Topeka 2528', Heeb 2792', Tor 2809',
Douglas 2823', Br li 2911', Lans 2928
DST 3094-3128 1 hr., 30' M
Drlg. 3182'

10/29 Cong. 3230', Simp 3235'
RTD 3243
5" @ 3239
DD 3248
S/½ BOPH 1000A, no help
DD 3258, S/1 BOPH 6 hr., 1000A
S/3 BOPH 12 hrs., 2000A

11/5 POP

11/12 Spud 10-13-52
Oil Well
TD 3258'
8" @ 310
Anhy 486, Top. 2528', Heeb 2792',
Tor. 2809, Doug. 2823', Br. lm
2911, Lans 2928
DST 3094-3128, opn 1 hr., rec.
30' mud
Cong. 3230', Arb. 3235
TD 3243
5" @ 3239

OVER

(Information Brought Forward)

1952
11/12 DD 3248 S/½ boph 1000A
DD 3258 S/1 boph 1000A
S/3 boph 2000A
Comp. 65 bopd

COMPLETED

FORM 275 FOR SALE BY KANSAS BLUE PRINT CO.

County Rice State Kansas

Sec. 20 (Blk. Twp.) 18 (Sur. Rge.) 10W Map No.

Operator Heathman & Co.

Well No. 1 Farm Schultz

Elev. Location SW SE SE



330 Ft. From S Line SE

990 Ft. From E Line Quarter

1st. Report OCT 15 1952

Completion

Remarks A-P farmout
Heathman - Contr.

Spudding Date 10-13-52

Drlg. Data Orth Pool

8" @ 310 Anhy 486 drlg. 675

J. G. McGEHEE

FORM 275 FOR SALE BY KANSAS BLUE PRINT CO.

County Rice State Kansas

Sec. 20 (Blk. Twp.) 18 (Sur. Rge.) 10W Map No.

Operator Heathman & Co.

Well No. 1 Farm Schultz

Elev. 1749 Location SW SE SE



330 Ft. From S Line SE

990 Ft. From E Line Quarter

1st. Report

Completion NOV 12 1952

Remarks

Heathman - Contr.

Spudding Date 10-13-52

Drlg. Data Oil well TD 3258

8" @ 310 Anhy 486 Top. 2528

Heeb. 2792 Tor. 2809 Doug. 2823

Br. lime 2911 Lans. 2928 DST 3094-3128

open 1 hr. Rec. 30' mud Cong. 3230

Arb. 3235 TD 3243 5" @ 3239 DD 3248

S/ ½ boph 1000 A DD 3258 S/ 1 boph

1000 A S/ 3 boph 2000 A

Comp. 65 bopd

J. G. McGEHEE